DIRECTION	MILEPOINT	LOCATION CODE (SHEET 2)	SIGN CODE	WIDTH (IN)	HEIGHT (IN)	SHEETING REMARKS	SIGN LEGEND	NEW SIGNS "A"	NEW SIGNS "B"	EXISTING SIGNS RETAIN	EXISTING SIGNS SALVAGE FROM	EXISTING SIGNS SALVAGE TO	EXISTING SIGNS REMOVE	EXIST POST RETAIN	EXIST POST REMOVE	NUMBER OF NEW POSTS	SQUARE STEEL (IN) 1.75 (LB/FT) 1.88	SQUARE STEEL (IN) 2.00 (LB/FT) 2.42	SQUARE STEEL (IN) 2.50 (LB/FT) 3.35	FOUNDATION	TUBULAR STEEL Ø (IN) 3.00 (LB/FT) 7.60	TUBULAR STEEL Ø (IN) 3.50 (LB/FT) 9.00	TUBULAR STEEL Ø (IN) 4.00 (LB/FT) 10.80	TUBULAR STEEL Ø (IN) 5.00 (LB/FT) 14.60	SIGN FRAME REQUIRED	REMARKS	SIGN DETAIL LOCATION SHSM	SIGN DETAIL LOCATION PROJECT SHEET #	SIGN DETAIL LOCATION STANDARD SHEET #
HARTLAND NB							FY-FLUORESCENT YELLOW FYG-FLUORESCENT YELLOW GREEN																				"SHSM"-STANDARD HIGHWAY SIGNS AND MARKINGS			
NB	1.555	A	M5-1L	21	15		(CONT.)	2.19																		**GREEN ON WHITE** "45 DEG LEFT ARROW"; INSTALL ON LEFT POST	X		
		A	M3-1	24	12			2.00																		**BLACK ON WHITE** "NORTH"	X		
		A	M1-4	24	24			4.00																		US ROUTE 5	X		
		A	M6-2R	21	15			2.19																		**BLACK ON WHITE** "45 DEG RIGHT ARROW"; INSTALL ON RIGHT POST	X		
NB	1.685	C	R2-1	24	30		SPEED LIMIT 25 (ON TOP)				1		1		X											STATION RD (TH-43); SALVAGE THE TOWN-OWNED SPEED LIMIT SIGN			
		C	VR-017	24	30		LEGAL LOAD LIMIT 24,000 POUNDS						1																
		C	VR-017	24	30			5.00								1		X									6	
		C	R2-1	24	30		SPEED LIMIT 25 (ON BOTTOM)					1														INSTALL THE SALVAGED SPEED LIMIT SIGN TO BELOW THE NEW LEGAL LOAD LIMIT SIGN			
NB	1.685	D	R1-1	30	30		STATION RD TH 43						0 ~~1~~	I	~~X~~						ALL SIGNS WERE REATINED (IN VERY GOOD CONDITION)					STATION RD (TH-43)			
		D	R1-1	30	30		0050 1409 0166	0 ~~6.25~~								1		X								NOTE: SKEWED INTERSECTION, HENCE SAME MILEPOINTS FOR STOP & LEGAL LOAD LIMIT SIGNS	X		
NB	1.706	A	VM-120	18	24		CT RIVER BYWAY			1				X															
		A	D6-4A	18	9		AMERICA'S BYWAYS (PLAQUE)			1																				
NB	1.716	B	W3-1	36	36		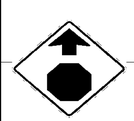						1		X															
		B	W3-1	36	36			9.00								2		X								SIGN FACES SB TRAFFIC	X		
NB	1.739	A	VD2-1	72	12		(SEE NEXT PAGE)	6.00								2		X								INSTALL THIS ASSEMBLY AS SHOWN IN THE SIGN LEGEND; INSTALL 25 FT± SOUTH OF THE EXISTING DESTINATION SIGN		16	
SIGN SUMMARY SHEET							SHEET TOTALS	~~30.38~~ ~~36.63~~	0.00	2	1	1	~~3~~ ~~4~~	0	0	6	90.0			0	0.0	0.0	0.0	0.0					
								SF	SF	EA	EA	EA	EA	EA	EA	EA	FT			EA	LB	LB	LB	LB					
VERMONT AGENCY OF TRANSPORTATION							TOWN DIRECTIONAL TOTALS	505.1	0.0	53	3	3	92	0	0	86	1290.0			0	0.0								

PROJECT NAME: **SPRINGFIELD-HARTFORD**
PROJECT NUMBER: **STPG SIGN(33)**

FILE NAME: **HARTLAND US-5 NB** PLOT DATE: **2/14/2012**
PROJECT MANAGER: **A. GAMBLE** DRAWN BY: **M. MILLER**
DESIGNED BY: **M. MILLER** CHECKED **A. GAMBLE**
HARTLAND US-5 NB 10 SHEET **123** OF **162**