DIRECTION	MILEPOINT	LOCATION CODE (SHEET 2)	SIGN CODE	WIDTH (IN)	HEIGHT (IN)	SHEETING REMARKS	SIGN LEGEND	NEW SIGNS "A"	NEW SIGNS "B"	EXISTING SIGNS RETAIN	EXISTING SIGNS SALVAGE FROM	EXISTING SIGNS SALVAGE TO	EXISTING SIGNS REMOVE	EXIST POST RETAIN	EXIST POST REMOVE	NUMBER OF NEW POSTS	SQUARE STEEL (IN) (LB / FT) 1.75 / 1.88	SQUARE STEEL (IN) (LB / FT) 2.00 / 2.42	SQUARE STEEL (IN) (LB / FT) 2.50 / 3.35	TUBULAR STEEL Ø (IN) FOUNDATION	TUBULAR STEEL Ø (IN) (LB / FT) 3.00 / 7.60	TUBULAR STEEL Ø (IN) (LB / FT) 3.50 / 9.00	TUBULAR STEEL Ø (IN) (LB / FT) 4.00 / 10.80	TUBULAR STEEL Ø (IN) (LB / FT) 5.00 / 14.60	SIGN FRAME REQUIRED	REMARKS	SIGN DETAIL LOCATION SHSM	SIGN DETAIL LOCATION PROJECT SHEET #	SIGN DETAIL LOCATION STANDARD SHEET #
HARTLAND SB							FY-FLUORESCENT YELLOW FYG-FLUORESCENT YELLOW GREEN																			"SHSM"-STANDARD HIGHWAY SIGNS AND MARKINGS			
SB	1.686	F	M1-5	24	24		VERMONT ROUTE 12 (CONT.)						1															
		F	M6-2L	21	15		(45 DEG) LEFT ARROW						1															
		F	M3-1	24	12		NORTH						1															
		F	M1-5	24	24		VERMONT ROUTE 12						1															
		F	M6-3	21	15		UP ARROW						1															
		F	VD1-1A	72	12		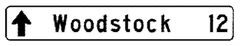	6.00																#3	(UP) WOODSTOCK 12; INSTALL THE SIGNS AS SHOWN IN THE SIGN LEGEND		13	
		F	VD1-1A	72	12			6.00																	(45 LEFT) WINDSOR 5; NOTE NEW SIGN CODES FOR DESTINATION SIGNS		5	
		F	M3-3	24	12			2.00																			**BLACK ON WHITE** "SOUTH"	X		
		F	M1-4	24	24			4.00																			US ROUTE 5	X		
		F	M6-2L	21	15			2.19																			**BLACK ON WHITE**; (45 DEG) LEFT ARROW	X		
		F	M4-5	24	12			2.00																			**WHITE ON BLUE** "TO"	X		
		F	M1-1	24	24			4.00																			INTERSTATE 91	X		
		F	M6-2L	21	15			2.19																			**WHITE ON BLUE**; (45 DEG) LEFT ARROW	X		
		F	M3-3	24	12			2.00																			**GREEN ON WHITE** "SOUTH"	X		
		F	M1-5	24	24		(CONT. ON NEXT PAGE)	4.00																			VERMONT ROUTE 12			E-136B
							SHEET TOTALS	34.38	0.00	0	0	0	5	0	0	0		0.0			0	0.0	0.0	0.0	0.0					
								SF	SF	EA	EA	EA	EA	EA	EA	EA		FT			EA	LB	LB	LB	LB					
							TOWN DIRECTIONAL TOTALS	487.9	0.0	62	0	0	97	0	0	69		1035.0			0	0.0								

SIGN SUMMARY SHEET

VERMONT AGENCY OF TRANSPORTATION

PROJECT NAME: **SPRINGFIELD-HARTFORD**
PROJECT NUMBER: **STPG SIGN(33)**

FILE NAME: **HARTLAND US-5 SB**
PROJECT MANAGER: **A. GAMBLE**
DESIGNED BY: **M. MILLER**
HARTLAND US-5 SB 8

PLOT DATE: **2/14/2012**
DRAWN BY: **M. MILLER**
CHECKED **A. GAMBLE**
SHEET **139** OF **162**