DIRECTION	MILEPOINT	LOCATION CODE (SHEET 2)	SIGN CODE	WIDTH (IN)	HEIGHT (IN)	SHEETING REMARKS	SIGN LEGEND	NEW SIGNS "A"	NEW SIGNS "B"	EXISTING SIGNS RETAIN	EXISTING SIGNS SALVAGE FROM	EXISTING SIGNS SALVAGE TO	EXISTING SIGNS REMOVE	EXIST POST RETAIN	EXIST POST REMOVE	NUMBER OF SQUARE STEEL NEW POSTS	SQUARE STEEL (IN) 1.75 (LB / FT) 1.88	SQUARE STEEL (IN) 2.00 (LB / FT) 2.42	SQUARE STEEL (IN) 2.50 (LB / FT) 3.35	TUBULAR STEEL Ø (IN) FOUNDATION	TUBULAR STEEL Ø (IN) 3.00 (LB / FT) 7.60	TUBULAR STEEL Ø (IN) 3.50 (LB / FT) 9.00	TUBULAR STEEL Ø (IN) 4.00 (LB / FT) 10.80	TUBULAR STEEL Ø (IN) 5.00 (LB / FT) 14.60	SIGN FRAME REQUIRED	REMARKS	SIGN DETAIL LOCATION SHSM	SIGN DETAIL LOCATION PROJECT SHEET #	SIGN DETAIL LOCATION STANDARD SHEET #
NORWICH US5 SB							FY-FLUORESCENT YELLOW FYG-FLUORESCENT YELLOW GREEN																				"SHSM"-STANDARD HIGHWAY SIGNS AND MARKINGS			
		F	M3-4	24	12								1																
		F	M1-5	30	24								1																
		F	M6-1	21	15								1																
		F	VD1-1A	72	12			6.00								2		X								NOTE REVISED ORDER		4	
		F	VD1-1A	72	12			6.00																				4	
		F	M3-3	24	12		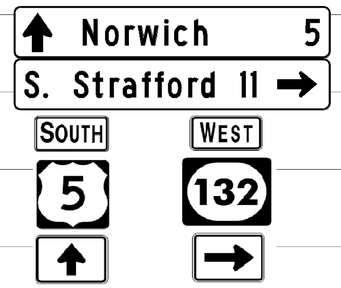	2.00																BLACK ON WHITE	X		
		F	M1-4	24	24			4.00																			X		
		F	M6-3	21	15			2.19																		BLACK ON WHITE	X		
		F	M3-4	24	12			2.00																		BLACK ON WHITE	X		
		F	M1-6	30	24			5.00																					E-136C
		F	M6-1	21	15			2.19																		BLACK ON WHITE	X		
SB	6.75	F	VR-017	24	30		LLL 24,000 LBS			1				X												ROUTE 132			
SB	6.73	F	RI-I ~~VR-017~~	24	30		STOP			1				X												ROUTE 132			
SB	6.67	G	VR-017	24	30								1		X											OLD BRIDGE ROAD TH-88			
		G	VR-017	24	30			5.00								1		X										E-141
							SHEET TOTALS	34.38	0.00	2	0	0	4	0	0	3		45		0	0.0	0.0	0.0	0.0					
								SF	SF	EA	EA	EA	EA	EA	EA	EA		FT		EA	LB	LB	LB	LB					
							TOWN DIRECTIONAL TOTALS	160.0	0.0	13.0	0.0	0.0	35	0.0	0.0	23		345.0		0		0.0							

SIGN SUMMARY SHEET

VERMONT AGENCY OF TRANSPORTATION

PROJECT NAME: **NORWICH - FAIRLEE**
PROJECT NUMBER: **STPG SIGN (34)**

FILE NAME: **10C334**
PROJECT MANAGER: **A. GAMBLE**
DESIGNED BY: **D.CROSSLEY**
NORWICH U.S. 5 SOUTHBOUND 2

PLOT DATE: **5/2/2011**
DRAWN BY: **D.CROSSLEY**
CHECKED BY: **QAU**