DIRECTION	MILEPOINT	LOCATION CODE (SHEET 2)	SIGN CODE	WIDTH (IN)	HEIGHT (IN)	SHEETING REMARKS	SIGN LEGEND	NEW SIGNS "A"	NEW SIGNS "B"	EXISTING SIGNS RETAIN	EXISTING SIGNS SALVAGE FROM	EXISTING SIGNS SALVAGE TO	EXISTING SIGNS REMOVE	EXIST POST RETAIN	EXIST POST REMOVE	NUMBER OF NEW POSTS	SQUARE STEEL (IN) (LB / FT) 1.75 / 1.88	SQUARE STEEL (IN) (LB / FT) 2.00 / 2.42	SQUARE STEEL (IN) (LB / FT) 2.50 / 3.35	TUBULAR STEEL Ø (IN) FOUNDATION	TUBULAR STEEL Ø (IN) (LB / FT) 3.00 / 7.60	TUBULAR STEEL Ø (IN) (LB / FT) 3.50 / 9.00	TUBULAR STEEL Ø (IN) (LB / FT) 4.00 / 10.80	TUBULAR STEEL Ø (IN) (LB / FT) 5.00 / 14.60	SIGN FRAME REQUIRED	REMARKS	SIGN DETAIL LOCATION SHSM	SIGN DETAIL LOCATION PROJECT SHEET #	SIGN DETAIL LOCATION STANDARD SHEET #
TINMOUTH SB							FY-FLUORESCENT YELLOW FYG-FLUORESCENT YELLOW GREEN																			"SHSM"-STANDARD HIGHWAY SIGNS AND MARKINGS			
SB	2.153	A	W11-5	30	30								1	X														
		A	W7-3A	24	18								1															
		A	W11-5	30	30			6.25																INSTALL NEW SIGNS ON EXISTING POST.	X		
		A	W7-3A	24	18			3.00																			X	
SB	1.394	F	W11-5	30	30		FARM MACHINERY						1		X													
		F	W11-4	30	30		CATTLE						1															
SB	1.180	F	VD1-1A	72	12		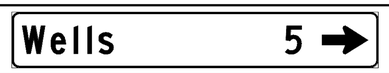	6.00				I	I			2		X		8FT	ADDITIONAL SIGN RELOCATED PER REQUEST FROM PROPERTY OWNER			INSTALL 10 FEET FROM POLE, 150 FEET NORTH OF EXISTING.		5	
SB	1.150	F	D1-1A	72	10		WELLS 5 --->						~~1~~		X													
		F	D1-1G	72	10		LAKE ST CATHERINE 8 --->						1															
SB	1.128	H	R1-1	24	24								1		X												E. WELLS RD. (TH-5)			
		H	R1-1	30	30			6.25								1		X								INSTALL BACK TO BACK ON SAME POST WITH LL24K	X		
SB	1.128	G	VR-017	24	30								1		X												E. WELLS RD. (TH-5)			
		G	VR-017	24	30			5.00																		INSTALL BACK TO BACK ON SAME POST WITH STOP SIGN (ABOVE) AND CLOSER TO VT-133.		6	
		G					TOWN'S REDUCED SPEED AHEAD SIGN						1															
SB	1.120	H	R1-1	30	30								1		X													
							SHEET TOTALS	26.50	0.00	0	0	~~0~~ I	~~10~~ 9	0	0	3	45.0			0	0.0	0.0	0.0	0.0					
								SF	SF	EA	EA	EA	EA	EA	EA	EA	FT			EA	LB	LB	LB	LB					
							TOWN DIRECTIONAL TOTALS	67.6	0.0	0	1	1	18	0	0	10	150.0			0	0.0								

SIGN SUMMARY SHEET

VERMONT AGENCY OF TRANSPORTATION

PROJECT NAME: **PAWLET - WEST RUTLAND**
PROJECT NUMBER: **STPG SIGN(37)**

FILE NAME: **10C340**
PROJECT MANAGER: **A. GAMBLE**
DESIGNED BY: **J. KELLY**
TINMOUTH SB SHEET 1

PLOT DATE: **5/6/2011**
DRAWN BY: **J. KELLY**
CHECKED **A. GAMBLE**
SHEET **27** OF **61**