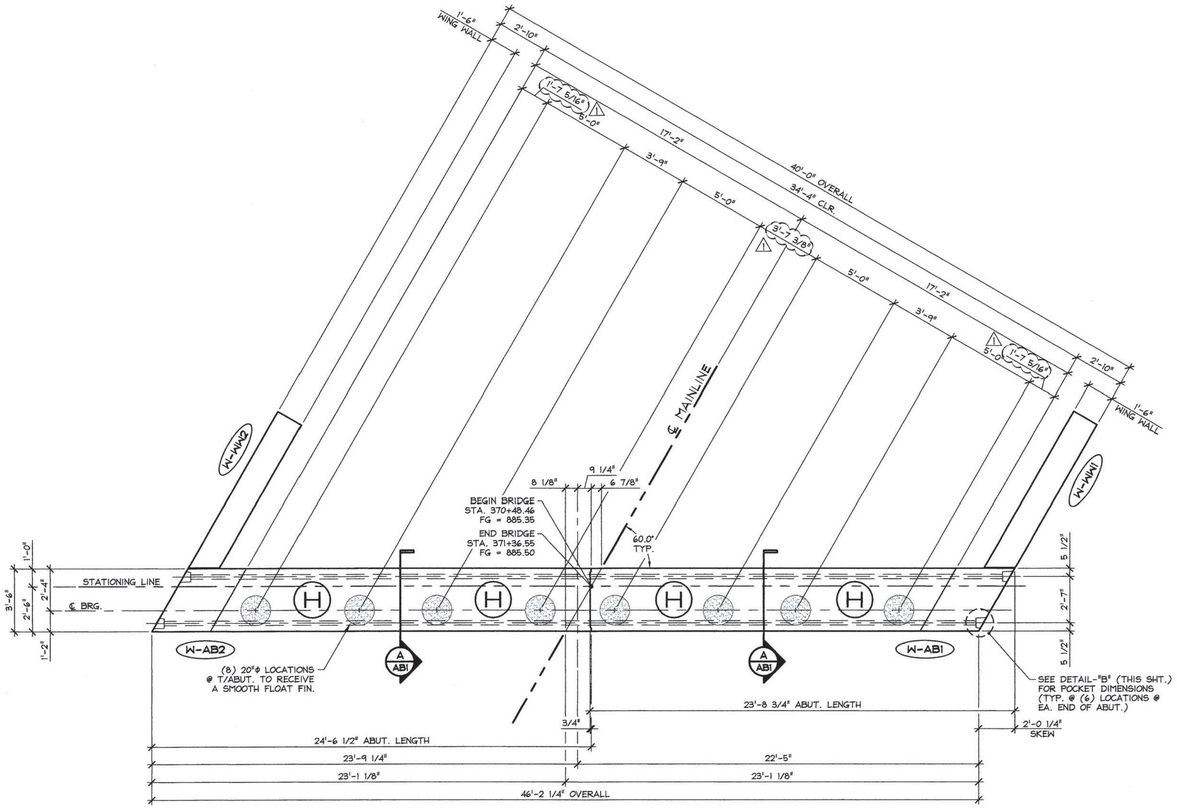

1 / AB1 ABUTMENT ASSEMBLY PLAN
1/4" = 1'-0"

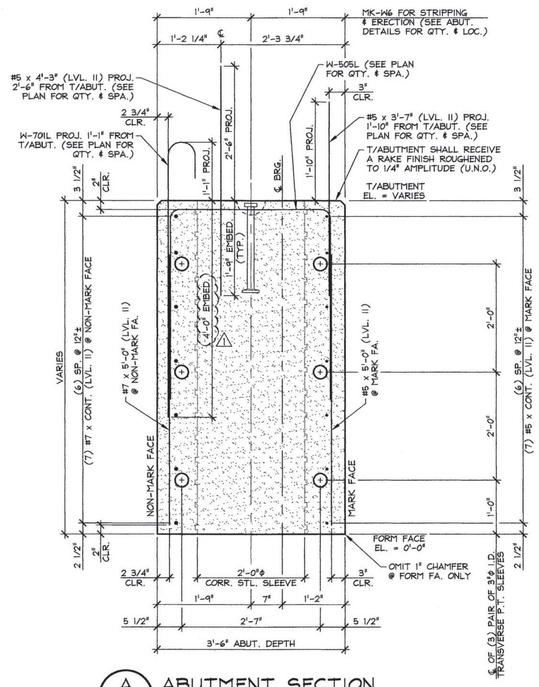

A / AB1 ABUTMENT SECTION
3/4" = 1'-0"

SHOP NOTE:
ALL EDGES OF ABUTMENT SHALL RECEIVE A 1" CHAMFER (U.N.O.)

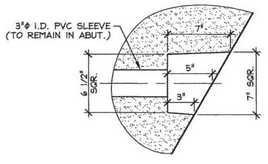

DETAIL - "B"
1 1/2" = 1'-0"

1-16-14 REVISED AS NOTED

APPROVAL STAMP:

Vermont Agency of Transportation
RECEIVED
CK'D BY JDG/JW OK'D BY WDL
January 27, 2014
RESUBMIT No Approved
BY KMH DATE 02/10/2014

J.P. CARRARA & SONS INC.
Precast & Prestress Manufacturer
2464 OSE STR., MIDDLEBURY, VERMONT 05753 Phone:(802)388-6361 Fax:(802)388-9010

MILLER CONSTRUCTION, INC.
CONTRACTOR
BARNARD, VERMONT

STATE OF VERMONT AGENCY OF TRANSPORTATION
COUNTY OF WINDSOR

DATE: DEC. 18, 2013
SCALE: NOTED
CHKD: - DFTM: B.L.
JOB NO: 23413-013

TOWN OF BARNARD
VT ROUTE 12, MAJOR COLLECTOR
BRIDGE NO.: 25 PROJECT NO.: ER BRF 0241(39)

PRECAST ABUTMENT PLAN, SECTION & DETAILS

DWG. NO: AB1

F:\VT-Bridges\23413-13 Barnard\23413-AB1.dwg, 1/16/2014 4:51:28 PM