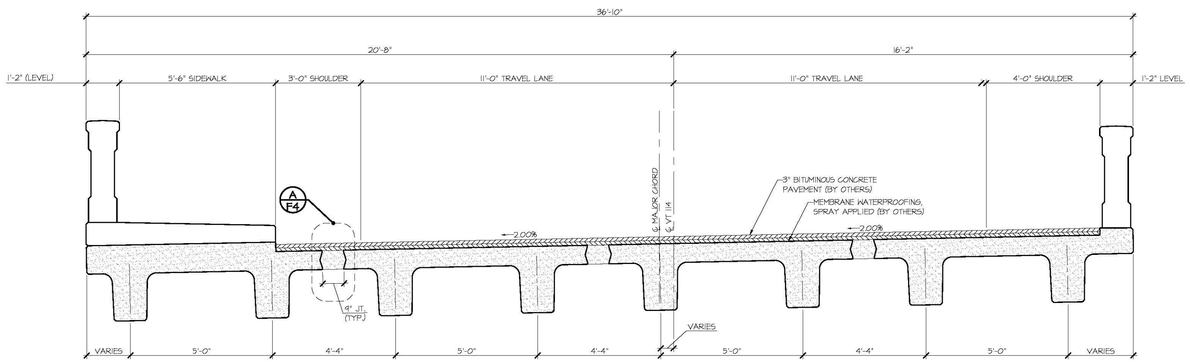

1 F4 NEXT BEAM TRANSVERSE SECTION
½" = 1'-0"

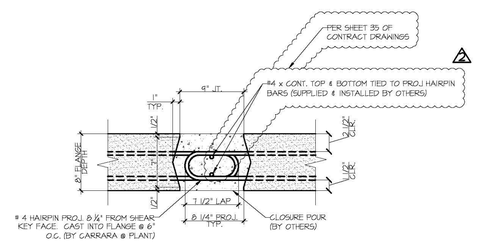

A F4 NEXT BEAM CLOSURE POUR
1 ½" = 1'-0"

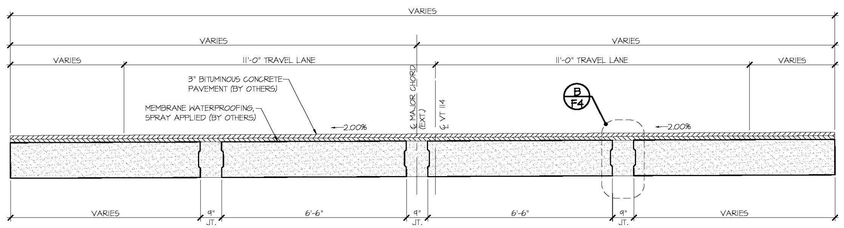

2 F4 APPROACH SLAB TRANSVERSE SECTION
½" = 1'-0"

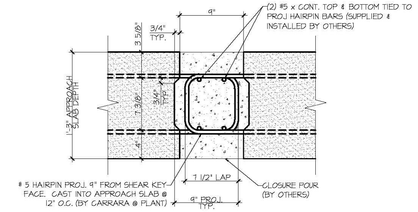

B F4 APPROACH SLAB CLOSURE POUR
1 ½" = 1'-0"

SHOP DRAWING REVIEW

☐ REVIEWED AS REQUIRED BY THE CONSTRUCTION CONTRACT DOCUMENTS AND APPROVED, BUT ONLY FOR CONFORMANCE TO THE DESIGN CONCEPT OF THE WORK, AND SUBJECT TO FURTHER LIMITATIONS AND REQUIREMENTS CONTAINED IN THE CONSTRUCTION CONTRACT DOCUMENTS.

☐ REJECTED ☐ REVISE AND RESUBMIT ☒ APPROVED AS NOTED

CORRECTIONS OR COMMENTS MADE ON THE SHOP DRAWINGS DURING THIS REVIEW DID NOT RELIEVE CONTRACTOR FROM COMPLIANCE WITH REQUIREMENTS OF THE DRAWINGS AND SPECIFICATIONS. THIS CHECK IS ONLY FOR REVIEW OF GENERAL CONFORMANCE WITH THE DESIGN CONCEPT OF THE PROJECT AND GENERAL COMPLIANCE WITH THE INFORMATION GIVEN IN THE CONTRACT DOCUMENTS. THE CONTRACTOR IS RESPONSIBLE FOR: CONFIRMING AND CORRELATING ALL QUANTITIES AND DIMENSIONS; SELECTING FABRICATION PROCESSES AND TECHNIQUES OF CONSTRUCTION; COORDINATING THEIR WORK WITH THAT OF ALL OTHER TRADES; AND PERFORMING THEIR WORK IN A SAFE AND SATISFACTORY MANNER.

CLD Consulting Engineers
140 Commercial Street
Manchester, NH 03101
603-669-8223

Job Number: 120121
Reviewed by: SRB
Date: 04/10/2015

Vermont Agency of Transportation
RECEIVED
CK'D BY _____ OK'D BY _____
April 6, 2015
RESUBMIT No Approved AsNoted
BY Rob Young DATE 04/13/2015

APPROVAL STAMP:

J.P. CARRARA & SONS INC.
Precast & Prestress Manufacturer
3464 DGE STR., MIDDLEBURY, VERMONT 05753 Phone:(802)388-4561 Fax:(802)388-9010

T. BUCK CONSTRUCTION, INC.
CONTRACTOR
AUBURN, MAINE

STATE OF VERMONT AGENCY OF TRANSPORTATION
COUNTY OF CALEDONIA

TOWN OF BURKE
VERMONT ROUTE 114
BRIDGE NO.: 13 PROJECT NO.: BRF 0269(13)

TRANSVERSE SECTIONS & DETAILS

DATE: MAR. 26, 2015
SCALE: NOTED
CHK'D: DFTM: JDK
JOB NO: 23454-015
DWG. NO: F4