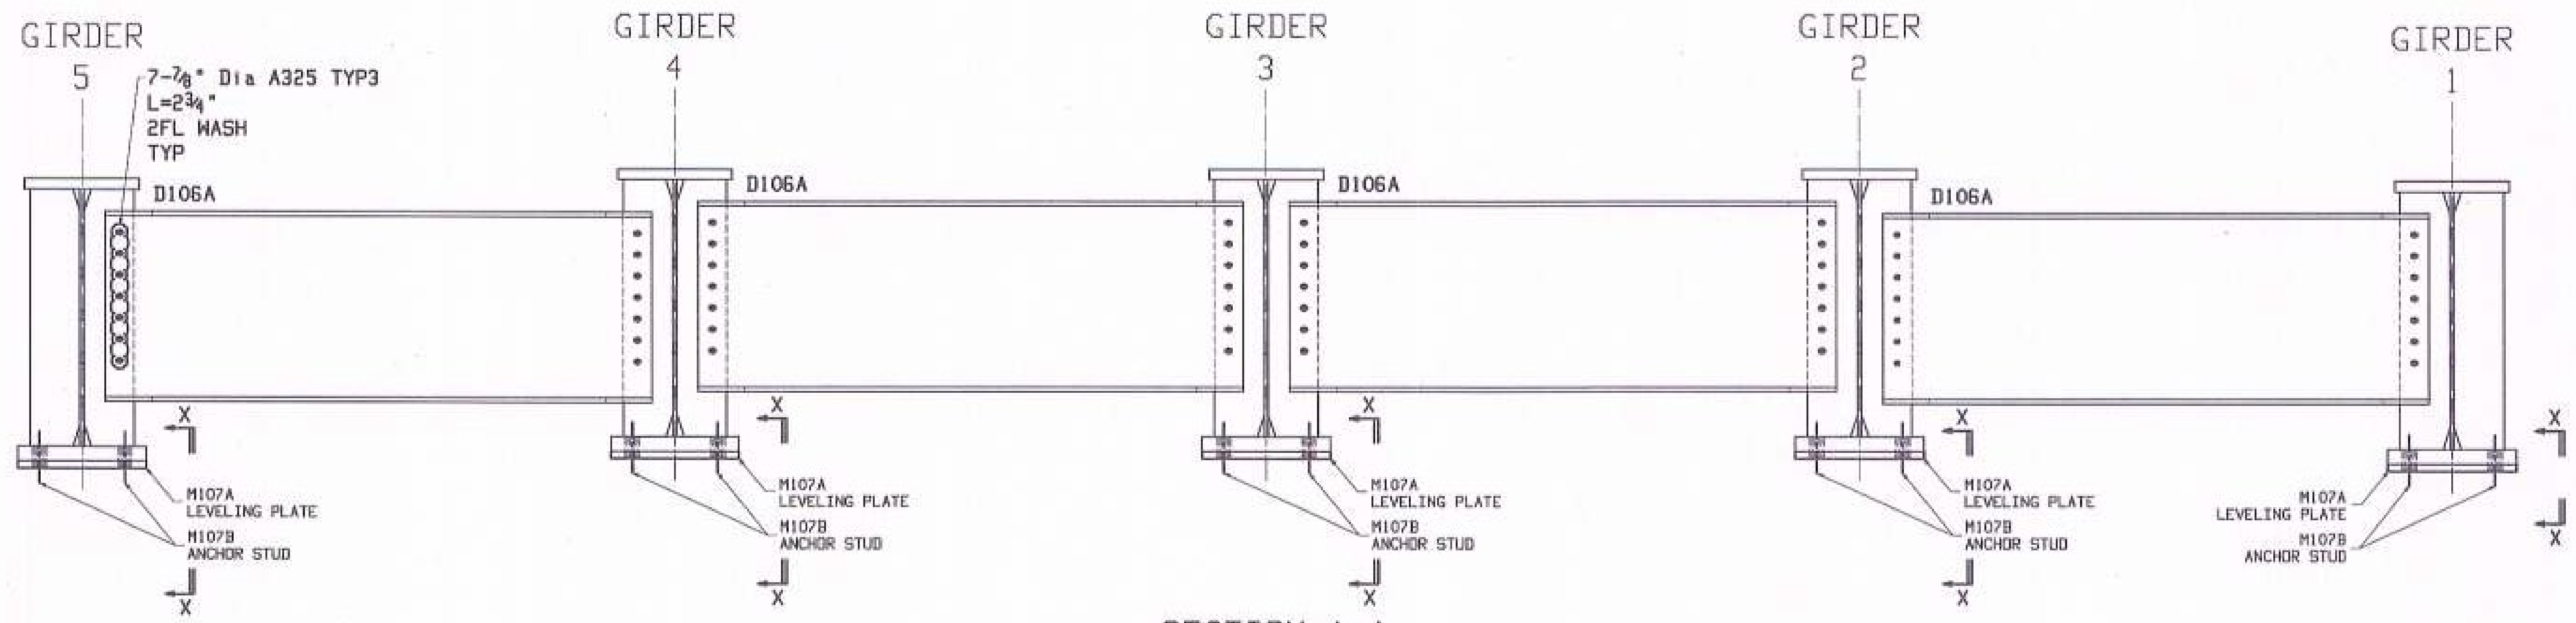

SECTION A-A

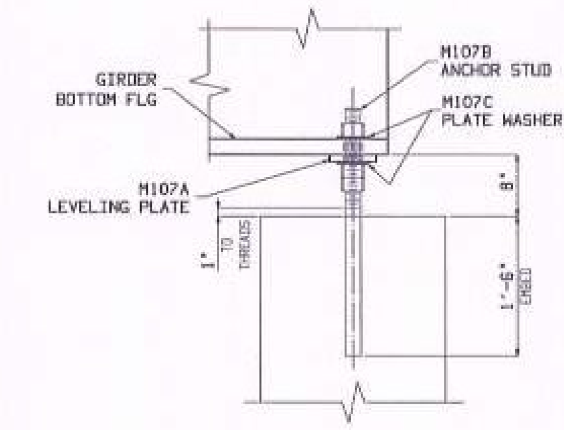

SECTION X-X

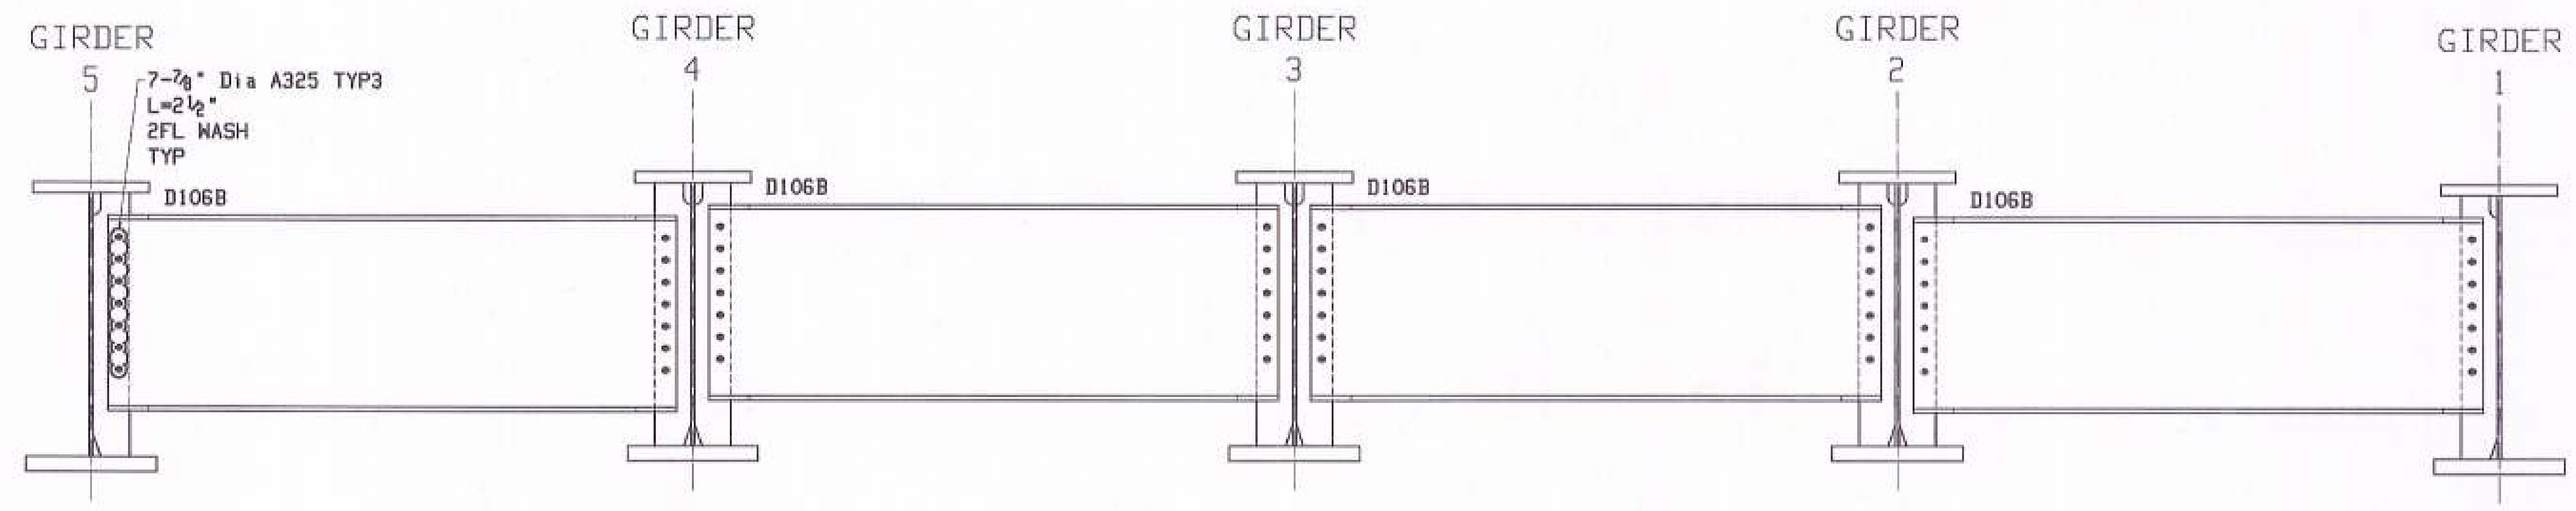

SECTION B-B

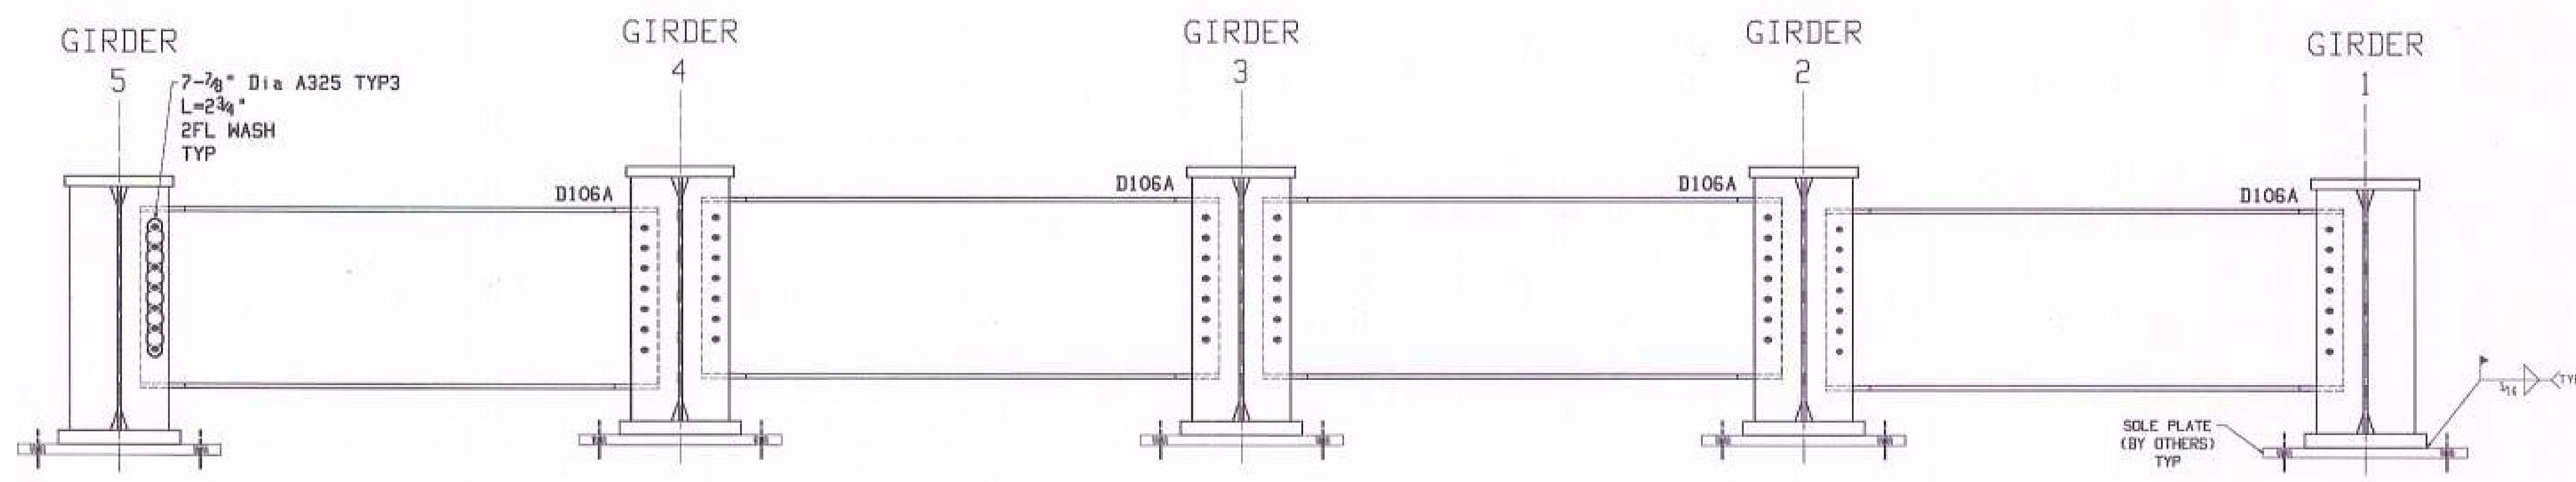

SECTION C-C

SHOP DRAWING REVIEW

☒ REVIEWED AS REQUIRED BY THE CONSTRUCTION CONTRACT DOCUMENTS AND APPROVED, BUT ONLY FOR CONFORMANCE TO THE DESIGN CONCEPT OF THE WORK, AND SUBJECT TO FURTHER LIMITATIONS AND REQUIREMENTS CONTAINED IN THE CONSTRUCTION CONTRACT DOCUMENTS.

☐ REJECTED ☐ REVISE AND RESUBMIT ☐ FURNISH AS CORRECTED

CORRECTIONS OR COMMENTS MADE ON THE SHOP DRAWINGS DURING THIS REVIEW DO NOT RELIEVE CONTRACTOR FROM COMPLIANCE WITH REQUIREMENTS OF THE DRAWINGS AND SPECIFICATIONS. THIS CHECK IS ONLY FOR REVIEW OF GENERAL CONFORMANCE WITH THE DESIGN CONCEPT OF THE PROJECT AND GENERAL COMPLIANCE WITH THE INFORMATION GIVEN IN THE CONTRACT DOCUMENTS. THE CONTRACTOR IS RESPONSIBLE FOR: CONFIRMING AND CORRELATING ALL QUANTITIES AND DIMENSIONS; SELECTING FABRICATION PROCESSES AND TECHNIQUES OF CONSTRUCTION; COORDINATING HIS WORK WITH THAT OF ALL OTHER TRADES; AND PERFORMING HIS WORK IN A SAFE AND SATISFACTORY MANNER.

VHB
Vanasse Hangen Brustlin, Inc.

Job Number: 57517.00
Reviewed By: B Magee
Date: 2-28-14

WORK THIS DRAWING
IN CONJUNCTION WITH E101

*** THIS DRAWING IS TO BE USED FOR MARKS AND BOLTS ONLY AND MUST BE READ IN CONJUNCTION WITH THE CONTRACT DRAWINGS SPECIFICATIONS AND SPECIAL PROVISIONS.
THIS DRAWING IS NOT TO BE USED FOR CONSTRUCTION SEQUENCING OR AS AN ERECTION PROCEDURE.

HEADS OF BOLTS MUST BE LOCATED ON THE EXTERIOR SIDE OF THE SPAN

P.S. THE NUTS TO BE INSTALLED ON THE LESS SEEN SIDE OF THE STRUCTURE

No	DESCRIPTION	DATE	BY	CHK
B	FOR 2nd APPROVAL	Feb 25 2014	LN	CG
A	FOR APPROVAL	Feb 5 2014	LN	CG

NOTE: BOLT 1 WASHER: 1 WASHER UNDER NUT U.N.
BOLT 2 WASHERS: 1 WASHER UNDER HEAD U.N.; 1 WASHER UNDER NUT U.N.

STRUCTAL
Building Better Bridges
386 River Road, Claremont, NH
T.603.542.5202 F.603.542.5317

PROJECT: VERMONT RTE 73
BRIDGE NO 19
TOWN OF ROCHESTER

TITLE: ERECTION SECTIONS

REFERENCE: PROJECT NUMBER: ER-BRF-0162 (18)

DRAWN BY: CRC	DATE: JANUARY 2014	CONTRACT NO: Q00540
CHECKED BY: CG	DATE: JANUARY 2014	DRAWING NO: E102