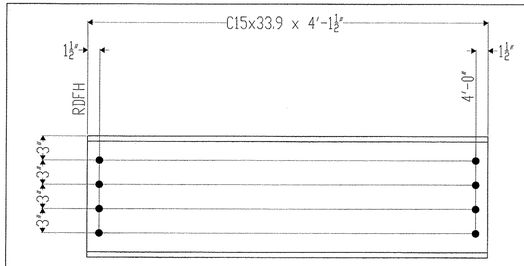

10 ~ DIAPHRAGMS ~ 7B1

SHIPPER		BILL OF MATERIAL						
NO.	MARK	NO.	MARK	SIZE	LENGTH	REMARKS	ITEM	WEIGHT
10	7D1			C15x33.9	4'-1½	-		

RECEIVED
OCT 17 2011
BY

CK'D BY _____ OK'D BY RSY
RESUBMIT _____ APPROVED ✓
DATE 10/18/2011

REV.NO	DATE	REVISION
1		
2		
3	-	-

DIAPHRAGM DETAIL

TOWN OF ROXBURY, WASHINGTON COUNTY, VT
PROJECT NUMBER: BHF 0187(8)
VT 12A, MAJOR COLLECTOR – BRIDGE 15

SHOP NOTES
HOLES- 15/16"ø UON
BOLTS- PER GN1
PAINT- NO PAINT
WELDS- N.A.
MATERIAL- M270 GR50W

PRECISE STRUCTURAL PRODUCTS
3 FARM LANE
GEORGETOWN, MA 01833
978-352-2951

OWNER: VT AGENCY OF TRANSPORTATION
CONTRACTOR: LUCK BROTHERS INC

DRAWN BY	CHECKED BY	APP.	SHOP	DES.	CONTRACT NO.	SHEET NO.
RC 10/07/11	WL 10/18/11				3590	7