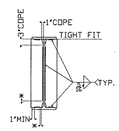

TYP. DIAPHRAGM STIFFENER WELD DETAIL

* NO WELD FOR 3/8" MIN. OR 7/8" MAX.

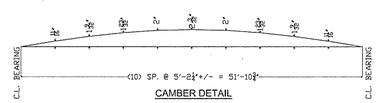

CAMBER DETAIL

SHIPPER		BILL OF MATERIAL						
NO.	MARK	NO.	MARK	SIZE	LENGTH	REMARKS	ITEM	WEIGHT
1	1B1			W30x90	55'-5	CVN		
		1	X1B	PL3/4x5	2'-4 3/8	CVN		
		1	X1C	PL3/4x5	2'-4 3/8	CVN		
		1	X1M	PL3/4x2 3/8	0'-7 3/4			
		94	ea	3/4" STUD	0'-7			

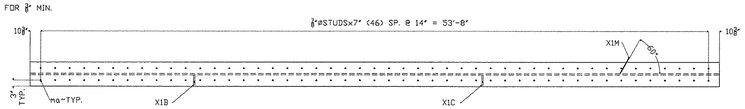

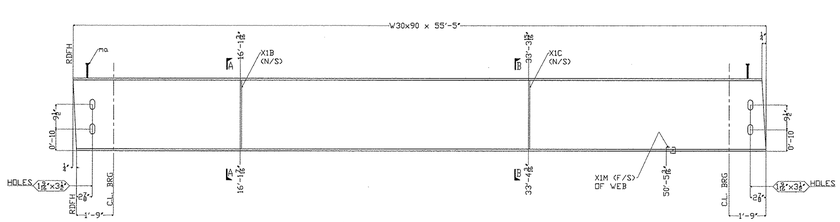

ONE ~ GIRDER DETAIL ~ 1B1

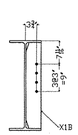

SECTION A-A

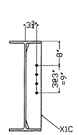

SECTION B-B

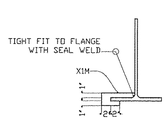

DETAIL OF DRIP BAR

RECEIVED
OK'D BY_____ OK'D BY RSY
OCT 17 2011
RESUBMIT_____ APPROVED ✓
BY DATE 10/18/2011

REV.NO	DATE	REVISION
3		
2		
1		

GIRDER DETAIL

TOWN OF ROXBURY, WASHINGTON COUNTY, VT
PROJECT NUMBER: BHF 0187(8)
VT 12A, MAJOR COLLECTOR – BRIDGE 15

SHOP NOTES
HOLES: 15/16"ø UON
BOLTS: PER ON1
PAINT: NO PAINT
WELDS: N.A.
MATERIAL: M270 GR.50W

PRECISE STRUCTURAL PRODUCTS
3 FARM LANE
GEORGETOWN, MA 01833
978-352-2251

OWNER: VT AGENCY OF TRANSPORTATION
CONTRACTOR: LUCK BROTHERS

DRAWN BY	CHECKED BY	APP.	SHOP	DIST.	CONTRACT NO.	SHEET NO.
KC 10/07/11	WL 10/10/11				3590	1