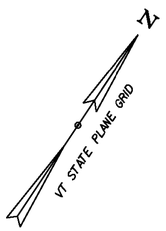

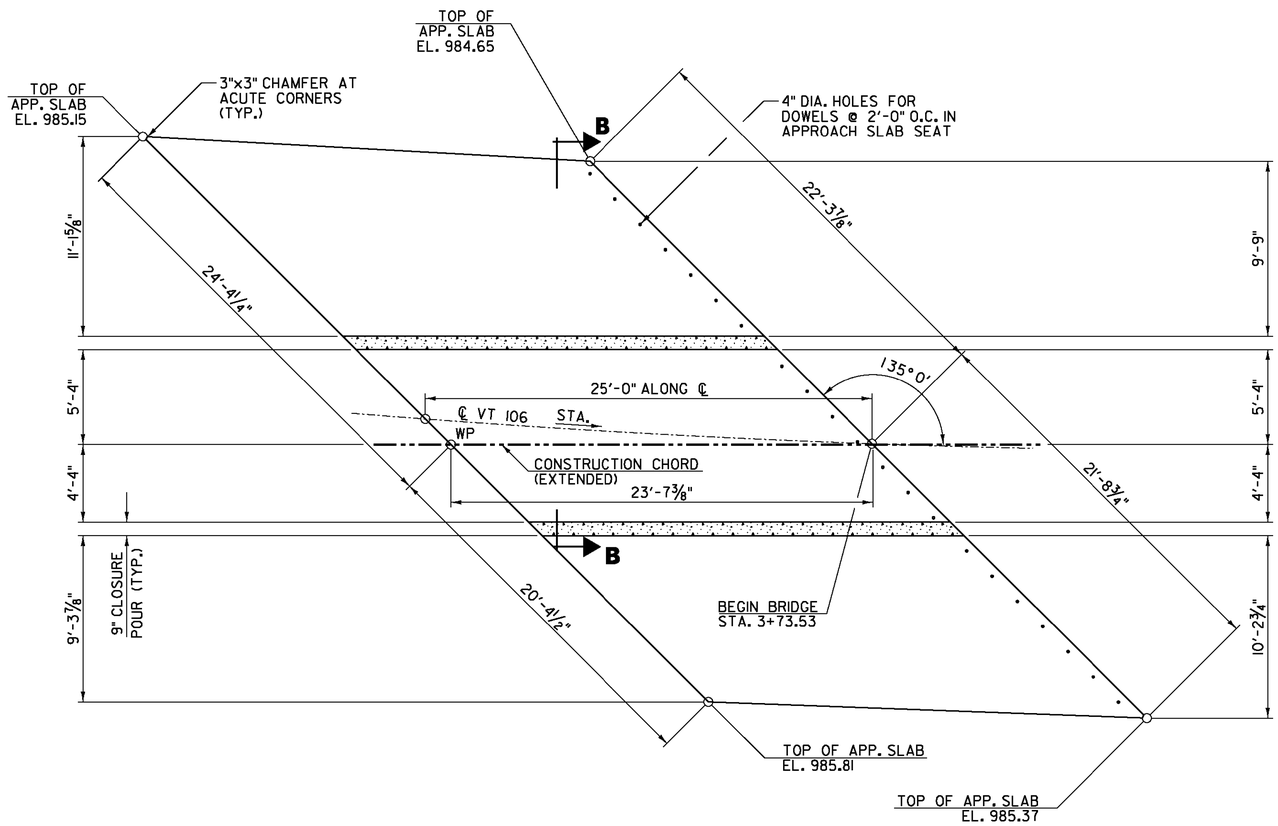

APPROACH SLAB 1 - PLAN
SCALE: 1/4" = 1'-0"

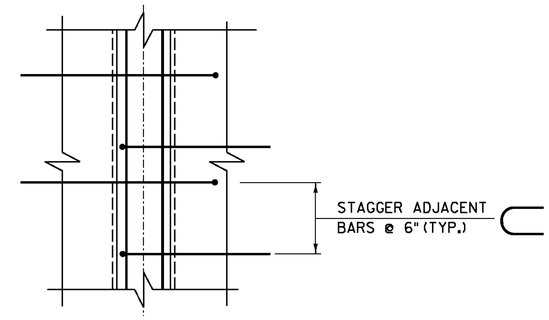

CONNECTION DETAIL PLAN
SCALE: 1" = 1'-0"

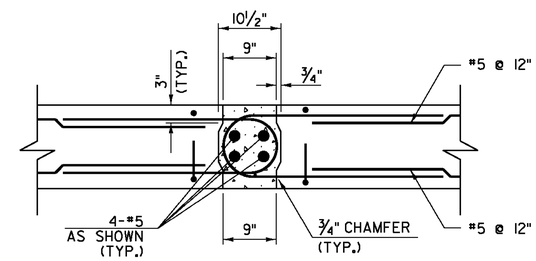

CONNECTION DETAIL SECTION
SCALE: 1" = 1'-0"

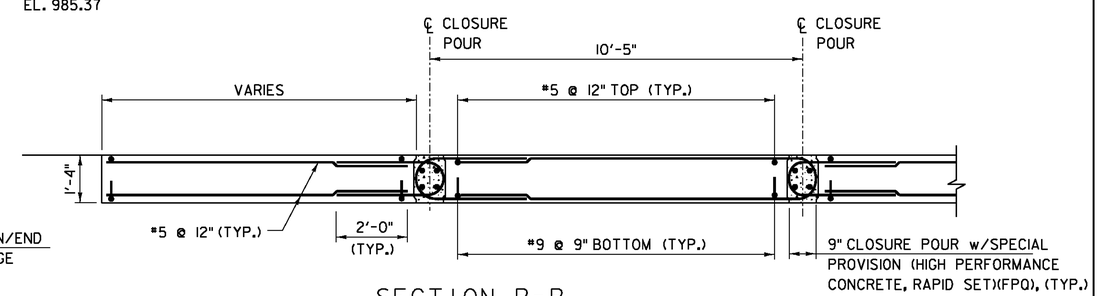

SECTION B-B
SCALE: 1/2" = 1'-0"

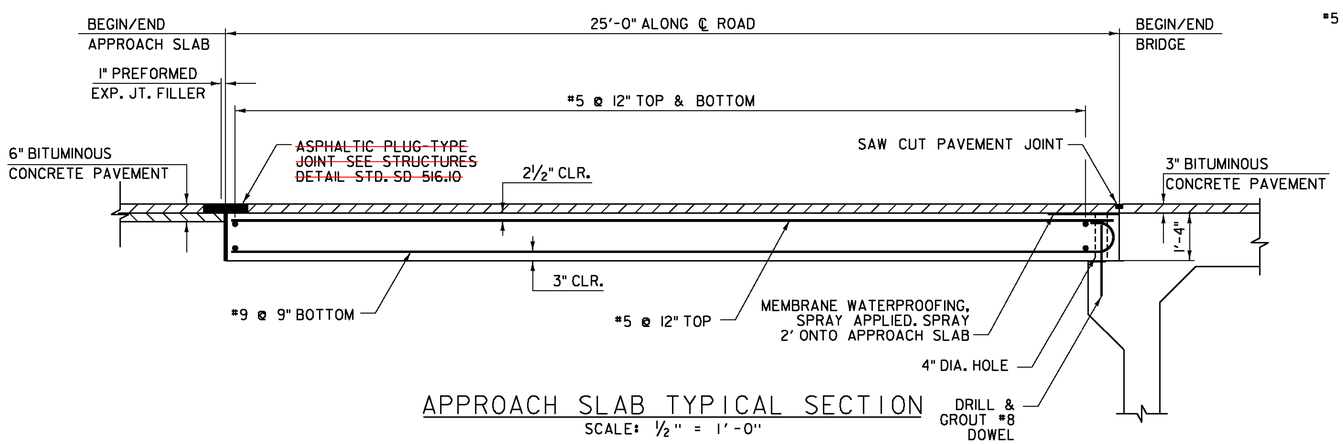

APPROACH SLAB TYPICAL SECTION
SCALE: 1/2" = 1'-0"

NOTE:
ALL REINFORCING IN CLOSURE POURS WILL BE PAID UNDER ITEM 507.12, REINFORCING STEEL, LEVEL II (FPQ).

Stantec

PROJECT NAME: WOODSTOCK	
PROJECT NUMBER: BRF 0151(21)	
FILE NAME: z10c426appslab.dgn	PLOT DATE: 9/24/2015
PROJECT LEADER: G. BOGUE	DRAWN BY: J. SOTER
DESIGNED BY: N. TIRK	CHECKED BY: T. KNIGHT
APPROACH SLAB DETAILS 1	SHEET 26 OF 50