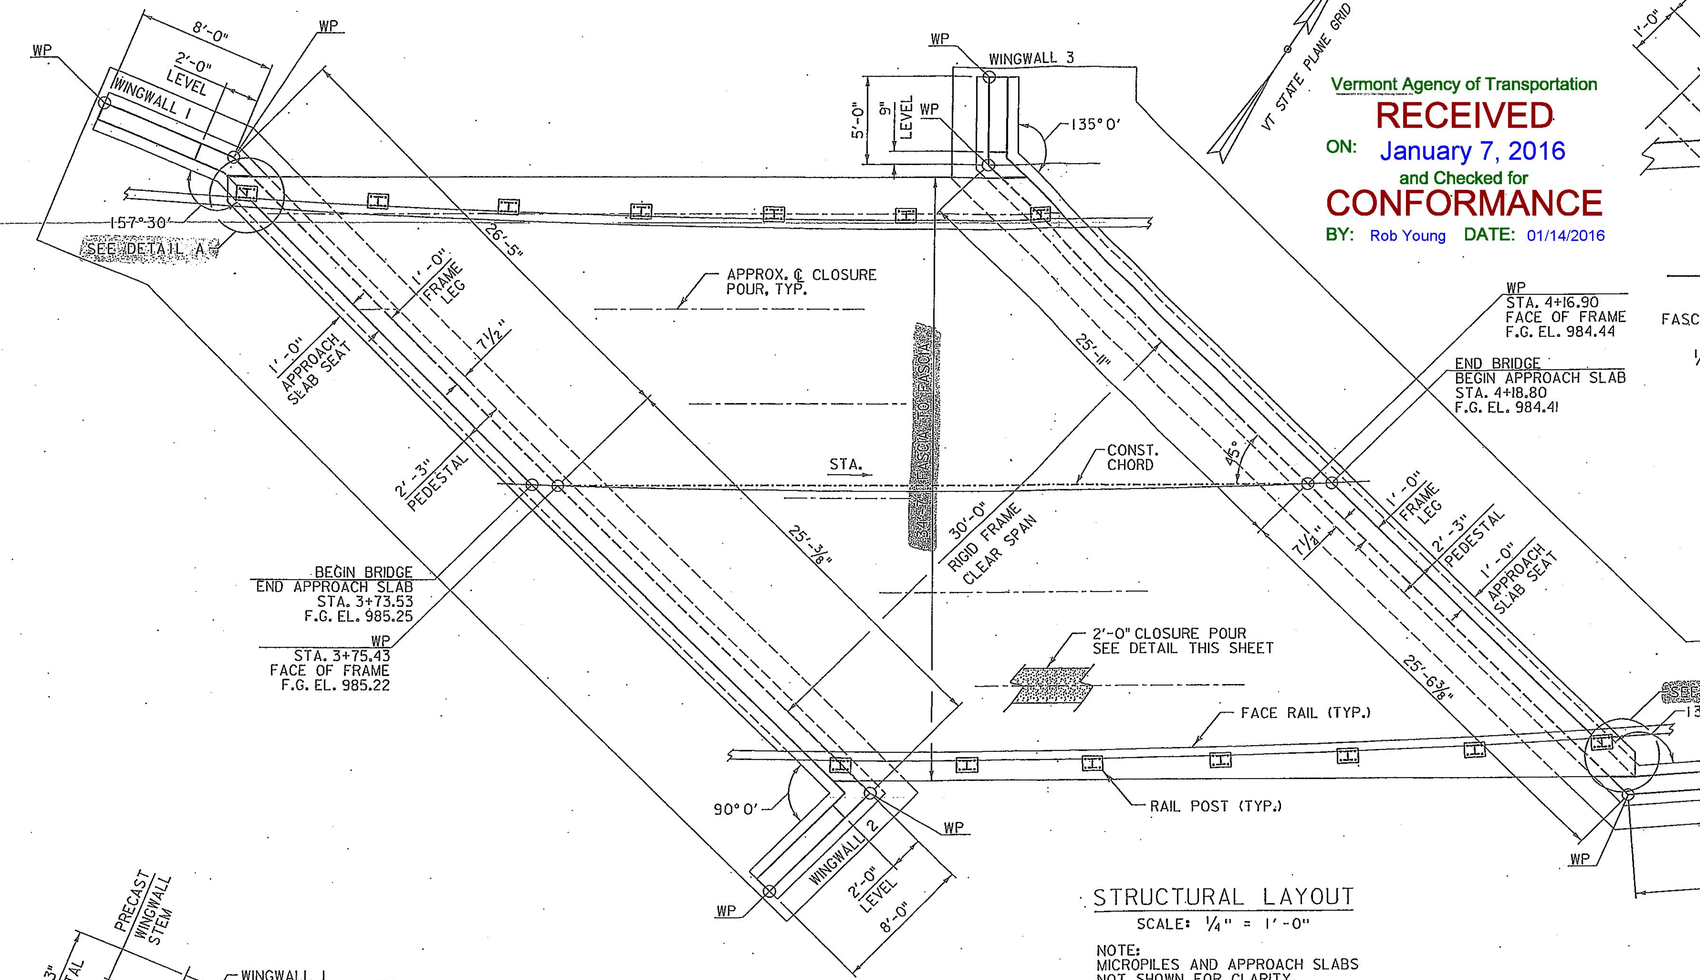

STRUCTURAL LAYOUT

SCALE: ¼" = 1'-0"

NOTE:
MICROPILES AND APPROACH SLABS
NOT SHOWN FOR CLARITY.

NOTE:
REINFORCING IN THE CLOSURE
POUR WILL BE PAID UNDER
ITEM 507.12, REINFORCING STEEL,
LEVEL II (FPO).

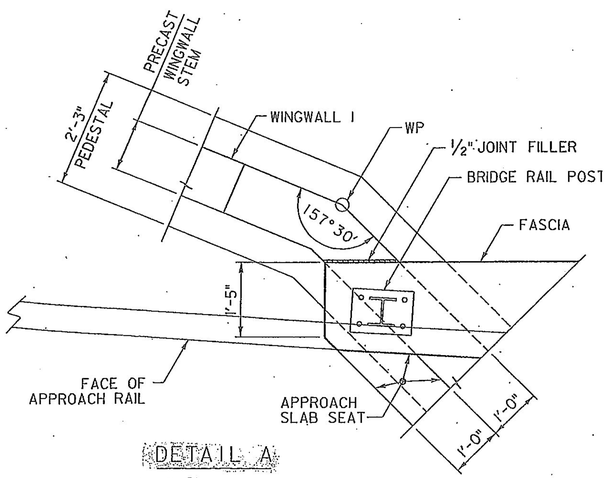

DETAIL A

SCALE ¾" = 1'-0"

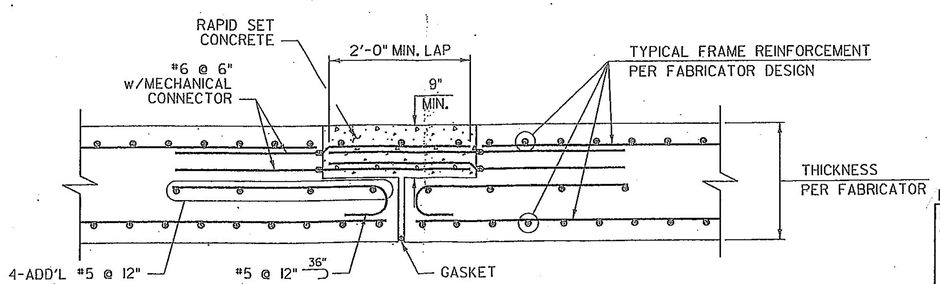

PRECAST FRAME ROOF CLOSURE POUR DETAIL

SCALE: 1" = 1'-0".

Vermont Agency of Transportation
RECEIVED
ON: January 7, 2016
and Checked for
CONFORMANCE
BY: Rob Young DATE: 01/14/2016

APPROVED - Contractor is responsible for dimensions, quantities and drawings and has determined and verified all field measurements and field conditions. Contractor is responsible for information contained on these drawings as it pertains to means, methods, techniques, sequences and procedures of construction. Contractor also indicates compliance with all information contained and does not relieve Contractor or Fabricator of compliance with all specifications and code requirements

APPROVED AS NOTED

REVISE AND RESUBMIT

NOT REVIEWED

Date: 1/13/16

By:

This review by Stantec Consulting Services Inc. is for the sole purpose of ascertaining conformance with the general design concept. This review shall not mean that Stantec Consulting Services Inc approves the detail design inherent in the shop drawings, responsibility for which shall remain with the Contractor. Submitting same, and such review shall not relieve the Contractor of his responsibility for errors or omissions in the shop drawing or of his responsibility for meeting all requirements of the Contract Documents. The contractor is responsible for dimensions to be confirmed and correlated at the job site, for information that pertains solely to the fabrication processes or to techniques of construction and installation and for coordination of the work of all subtrades.

Stantec

ITEM #: 525.335

STRUCTURAL STEEL TO COMPLY W/ ASTM A6

TOLERANCE UNLESS OTHERWISE NOTED:
FRACTIONS = ± 1/16"
ANGLES = ± 1/2"
DIAMETERS = ± 1/32"

SHEET 3 OF 4

BRIDGE RAIL DETAILS SHEET

VERMONT ROUTE 108 (MAJOR COLLECTOR, RURAL), BRIDGE # 24
TOWN OF WOODSTOCK, COUNTY OF WINDSOR, VT.

R E V	NO.	DATE	DESCRIPTION	BY

R E V	NO.	DATE	DESCRIPTION	BY

ELDERLEE, INC.
OAKS CORNERS, NEW YORK 14518
email:dlong@elderlee.com / epeck@elderlee.com
Tel:315-789-6870 Fax:315-789-6815

NYSDOT CERTIFIED FABRICATOR
ORTHOGRAPHIC PROJECTION

DRAWN	E.P.	11/30/15
CHECKED	D.L.	11-23-15
APPROVED		
SCALE	SCHEMATIC	
DRAWING NO.	P.R. LaFAYETTE-WOODSTOCK (16	