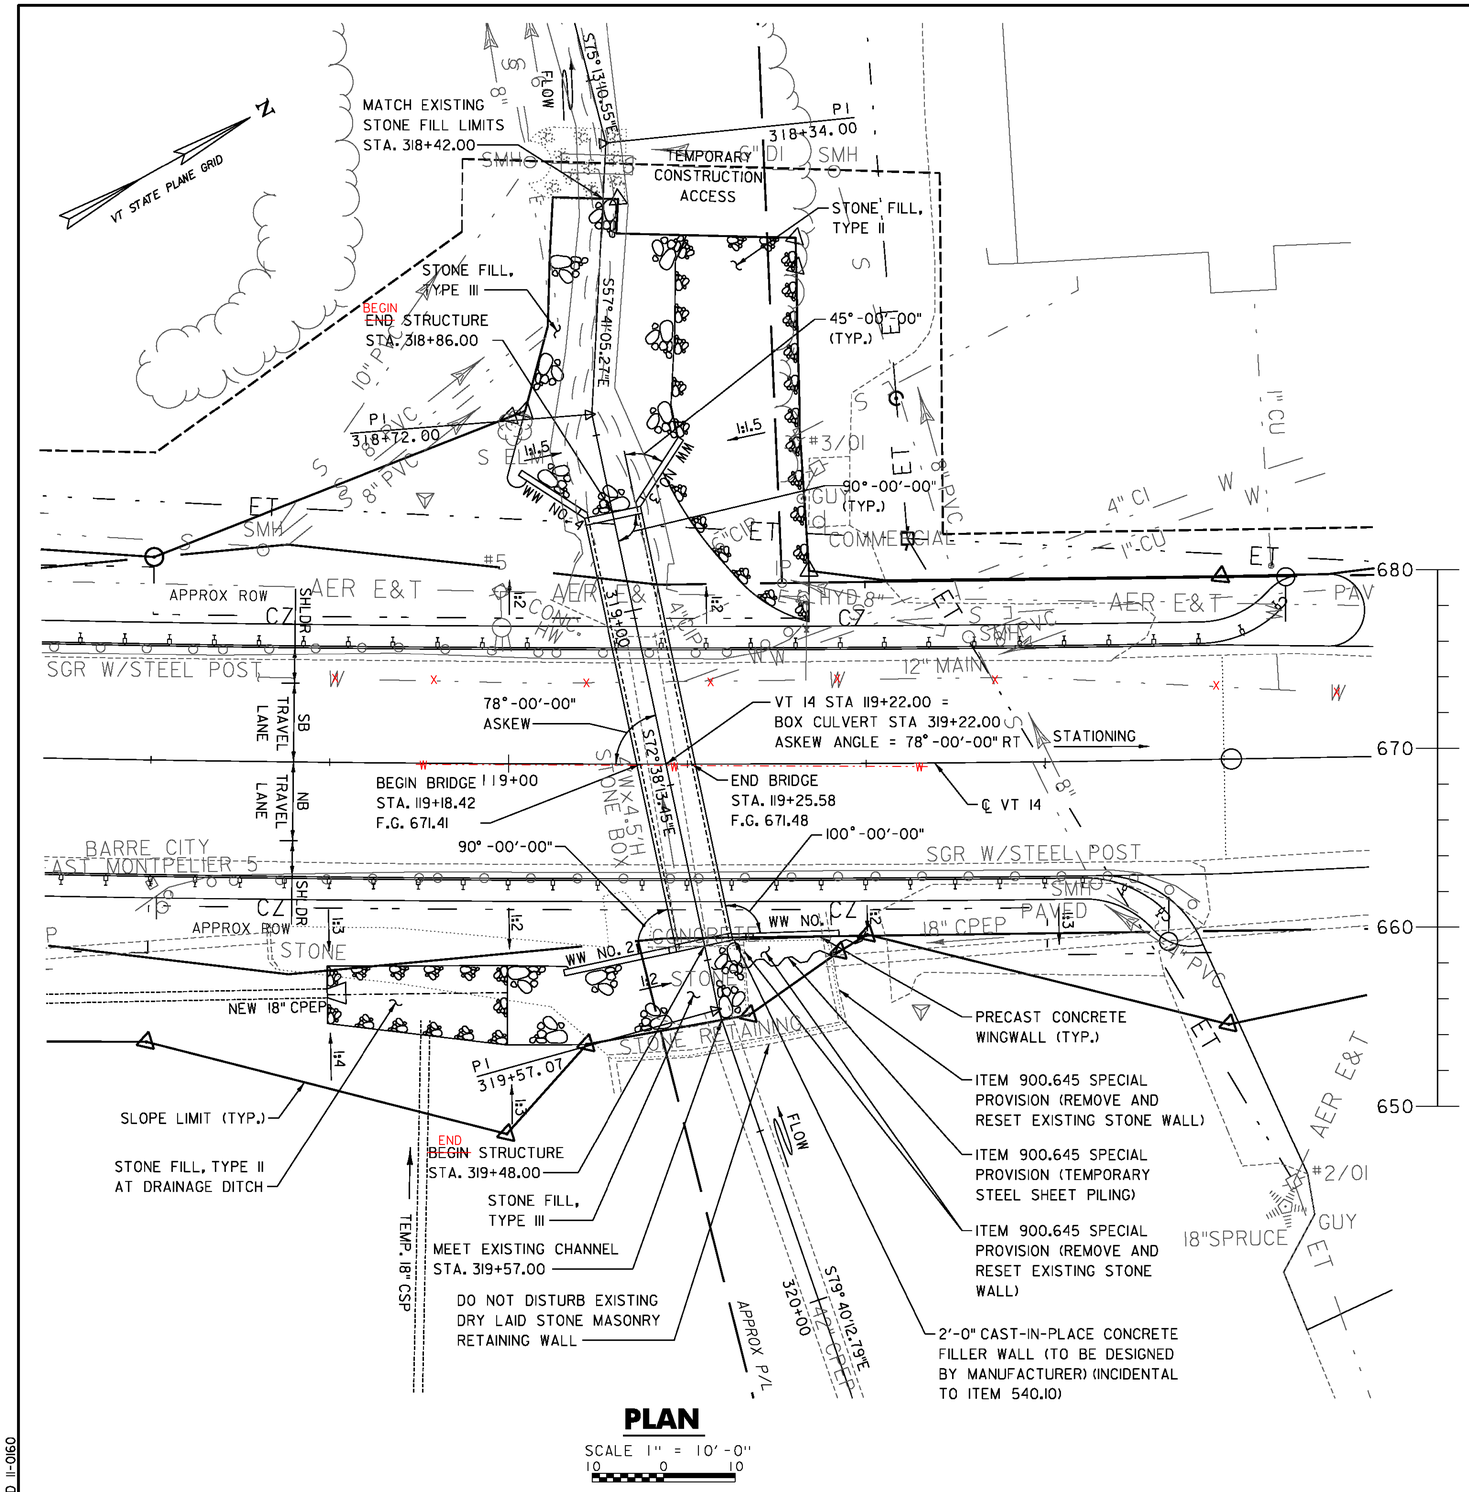

PLAN

SCALE 1" = 10'-0"

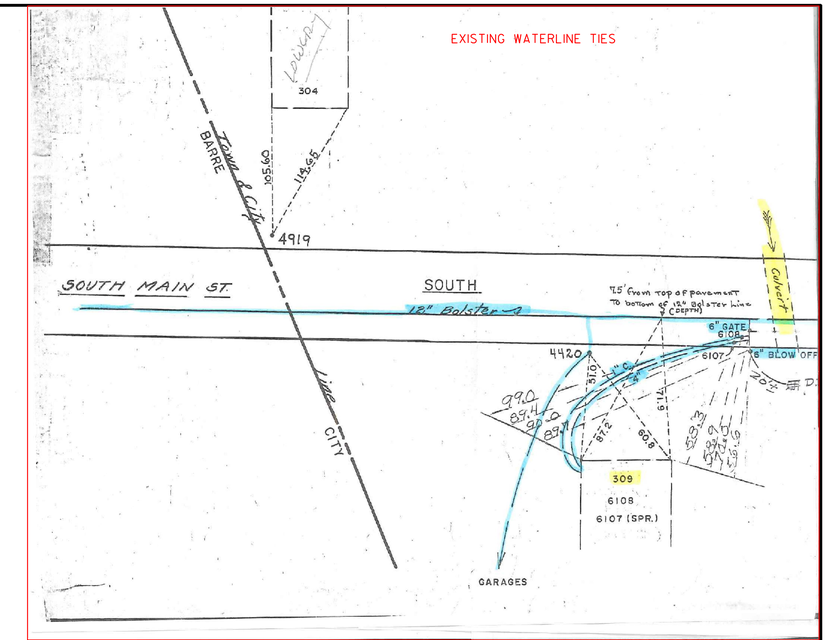

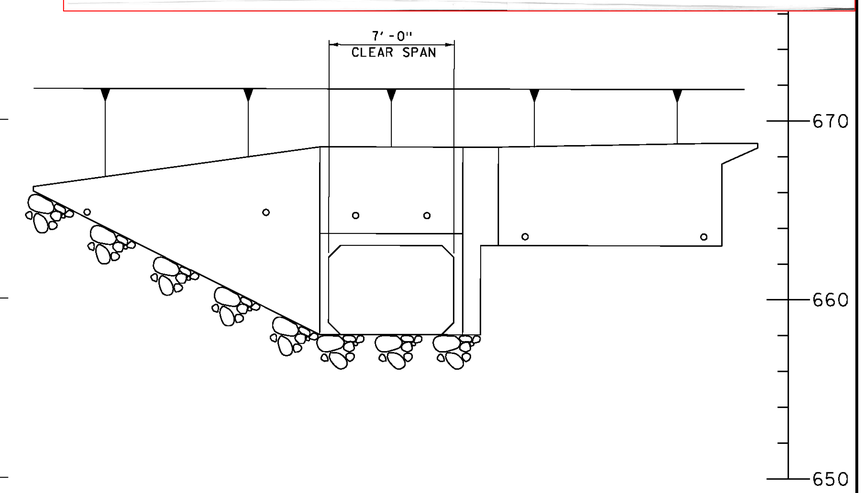

UPSTREAM ELEVATION

SCALE 1/4" = 1'-0"

PROJECT NAME: BARRE TOWN	
PROJECT NUMBER: STP SCRP(10)	
FILE NAME: z10d202pe.dgn	PLOT DATE: 2/13/2014
PROJECT LEADER: K. UPMAL	DRAWN BY: M. SMITH
DESIGNED BY: S. BEAUMONT	CHECKED BY: J. BYATT
CULVERT PLAN AND ELEVATION	SHEET 25 OF 43

CLD 11-0160