STATE OF VERMONT
AGENCY OF TRANSPORTATION

TRAFFIC SIGN SUMMARY SHEET

MILE MARKER, STATION, OR SIGN NUMBER	SIGN LEGEND	SIGN DIMENSIONS EA	WIDTH (IN)	HEIGHT (IN)	NEW & SALVAGED SIGNS "A"	"B"	SALV SIGN	SALV TIS	EXIST POST RETAIN	SALVAGE	NEW SIGN POSTS NO. OF POSTS	FLANGED CHANNEL LB/FT 1.12	2.0	3.0	SQUARE STEEL (IN) 1.75 LB/FT 1.88	2.0 2.42	2.5 3.35	ANCHOR	SLEEVE	TUBULAR ALUMINUM Ø (IN) 3.0 LB/FT 1.3	4.0 1.7	4.0 MOD 1.7	FOUNDATION	TUBULAR STEEL Ø (IN) 3.0 LB/FT 7.6	3.5 9.0	4.0 10.8	5.0 14.6	W-SHAPE STEEL FTG. SIZE 24"	30"	WEIGHT	POST SIZE	SIGN REMAINED REQUIRED	REMARKS	SIGN DETAIL DETAIL ON SHEET NUMBER	STD. SHEET NUMBER
											OPTION ITEMS																									
VT 103																																			
102+00, RT 102+32, LT		2 2	30 24	30 12	12.5 4.00						2					X		X																	W11-2: SIGN BACKGROUND SHALL BE FLUORESCENT YELLOW GREEN W16-7: SIGN BACKGROUND SHALL BE FLUORESCENT YELLOW GREEN		SHSM SHSM
102+56, RT		1 1 1	24 6 30	12 10 30	2.00 6.25		0.42				1					X		X																	STREET SIGN SHALL HAVE GREEN BACKGROUND WITH WHITE LETTERING VD-700 R1-1	29	 T-44 SHSM
102+69, RT 103+50, LT		2	6	8	0.67						2				X			X																	VD-701		T-42
104+91, LT		1	40	12	3.33						0																							STREET SIGN SHALL HAVE GREEN BACKGROUND WITH WHITE LETTERING	29	
AVERAGE POST LENGTH = 15 FEET FINAL POST LENGTHS ARE TO BE DETERMINED IN THE FIELD. POST SIZES ARE COMPUTED BASED ON INFORMATION FURNISHED ON THE STANDARD SHEETS AND THE VTRANS "SIGN POST DESIGN GUIDELINE."												FT	FT	FT	FT 30	FT 45	FT		EA	LB	LB	LB		LB	LB	LB	LB								
	TOTALS	SF 28.75	SF	EA. 1	SF							FT			FT 75					LB			EA.	LB				EA.	EA.	LB					

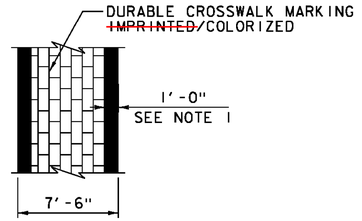

DETAIL OF ITEM 900.640, "SPECIAL PROVISION (DURABLE CROSSWALK MARKING, ~~IMPRINTED~~/COLORIZED)

NOT TO SCALE

NOTES:

1. PERMANENT CROSSWALKS SHALL HAVE A DURABLE 12 INCH WIDE THERMOPLASTIC WHITE LINE PLACED ON THE OUTSIDE EDGES OF THE ~~INLAID BRICK PATTERN~~ PAINTED CROSSWALK WILL BE CONSIDERED INCIDENTAL TO PAY ITEM 900.640, "SPECIAL PROVISION (DURABLE CROSSWALK MARKING, ~~IMPRINTED~~/COLORIZED)".
2. THE PER FOOT COST OF INSTALLED PERMANENT CROSSWALK MARKINGS WILL BE PAID FOR AS ITEM 900.640, "SPECIAL PROVISION (DURABLE CROSSWALK MARKING, IMPRINTED/COLORIZED)".

CROSSWALKS PAINTED WITH SHERWIN WILLIAMS "LUDLOW BRICK RED" SETFAST TM 5628 ACRYLIC TRAFFIC PAINT

PROJECT NAME: LUDLOW
PROJECT NUMBER: BRF 025-1(42)

FILE NAME: z10j068tss.dgn
PROJECT LEADER: A.P. GUYETTE
DESIGNED BY: E.A. FIALA
TRAFFIC SIGN SUMMARY SHEET

PLOT DATE: 8/23/2016
DRAWN BY: E.A. FIALA
CHECKED BY: A.P. GUYETTE
SHEET 30 OF 73

VHB 57435