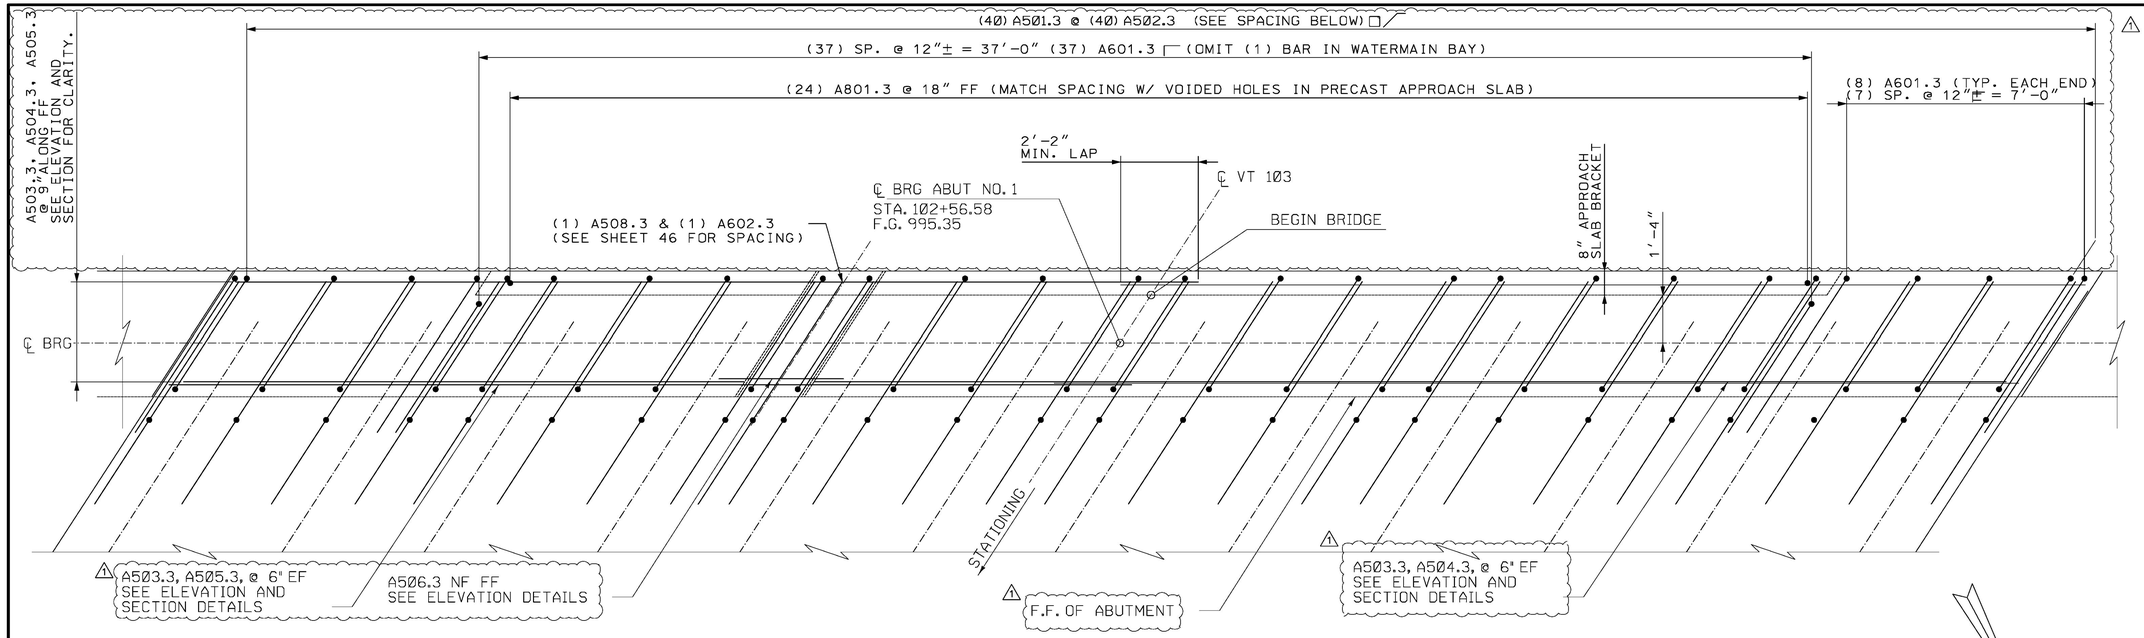

ABUTMENT NO. 1
DECK ABUTMENT CONNECTION REINFORCING PLAN
SCALE ½" = 1'-0"

NOTES:
1. ABUTMENT NO. 1 REINFORCING SHOWN. ABUTMENT NO. 2 REINFORCING SIMILAR.
2. ITEM 524.21, "JOINT SEALER, POLYURETHANE", SHALL BE APPLIED OVER THE CORK AND ON THE FAR FACE OF THE MATCH CAST VERTICAL CONSTRUCTION JOINTS.

VT STATE PLANE GRID

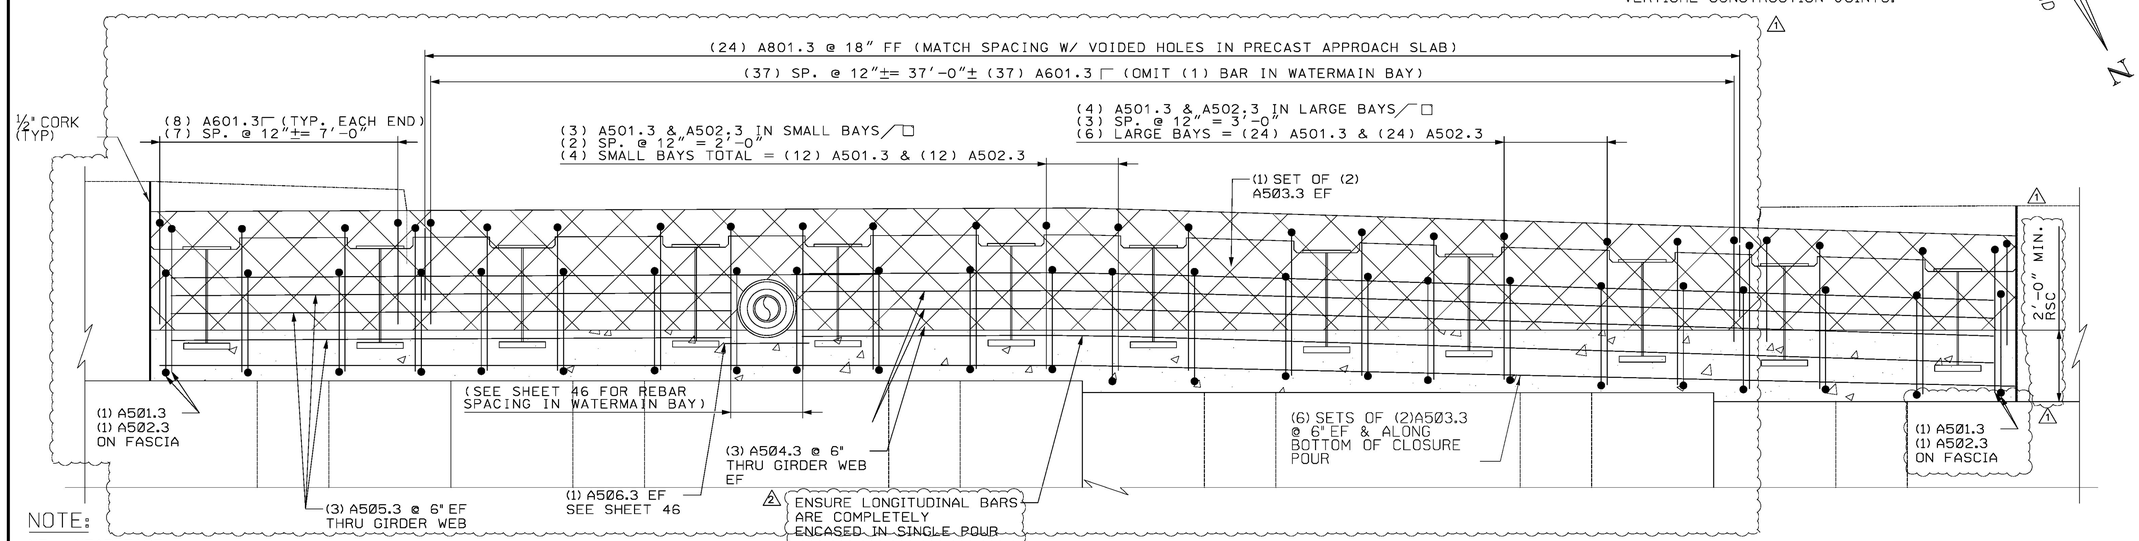

NOTE:
NF = NEAR FACE
FF = FAR FACE
EF = EACH FACE
▲ = CUT TO FIT IN FIELD
3" CLEAR, UNLESS OTHERWISE SPECIFIED ON THE PLANS.
2'-2" BAR LAP UNLESS OTHERWISE SPECIFIED ON THE PLANS.

ABUTMENT NO. 1
DECK ABUTMENT CONNECTION REINFORCING ELEVATION
SCALE ½" = 1'-0"

CALDERWOOD ENGINEERING, ETC.
STRUCTURAL ENGINEERING • DETAILING SERVICES
222 RIVER RD, RICHMOND, ME 04357 PH/FX (207)737-2007/(207) 737-2008

PREPARED FOR:
COLD RIVER BRIDGES, LLC

CEE 16-16-COLDRIVERBRIDGES
01-CS-LUDLOW

STATE OF VERMONT — JEREMY T. CALDERWOOD — NO. 8711 — LICENSED PROFESSIONAL ENGINEER

P.E. NUMBER 8711

DATE

BY	DATE
TDC	JAN 2017
TDC	MAR 2017
TDC	APR 2017

DESIGN-DETAILED: TDC
CHECKED-REVIEWED:

REVISIONS 1
REVISIONS 2
REVISIONS 3
REVISIONS 4
FIELD CHANGES

VE SUPER DESIGN
LUDLOW VT. BRF 025-1(42)

DECK-ABUTMENT REINFORCEMENT

SHEET NUMBER
47
of 73

CALDERWOOD ENGINEERING, ETC. 222 River Road RICHMOND, ME 04357 PH. (207) 737-2007 FAX (207) 737-2008