


102+50

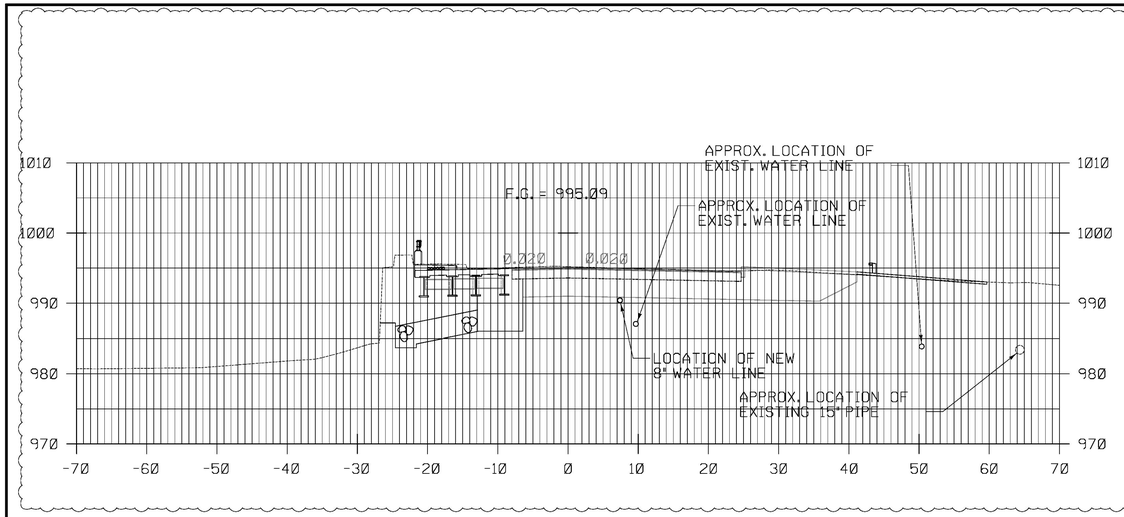


102+25




102+00

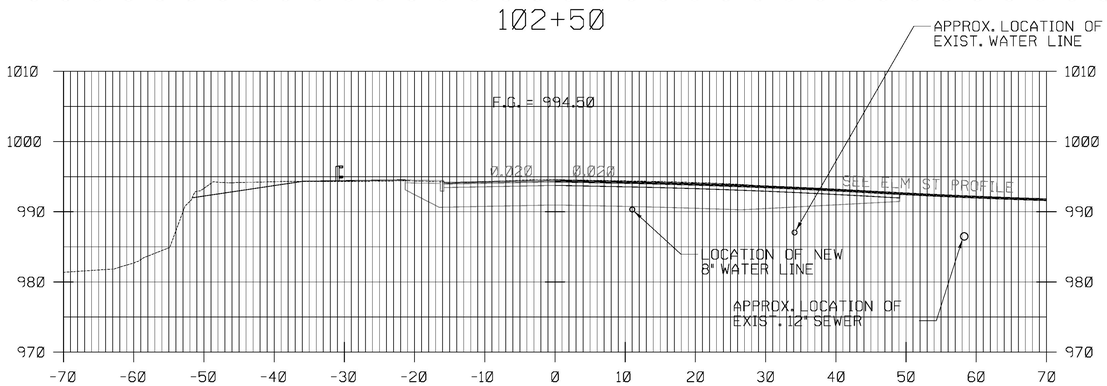


103+25

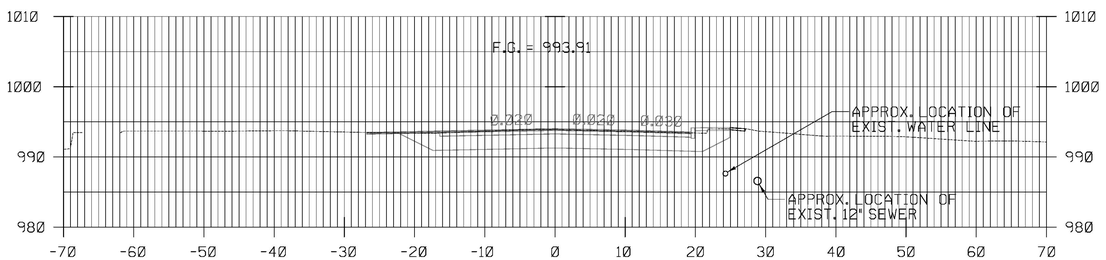


103+00

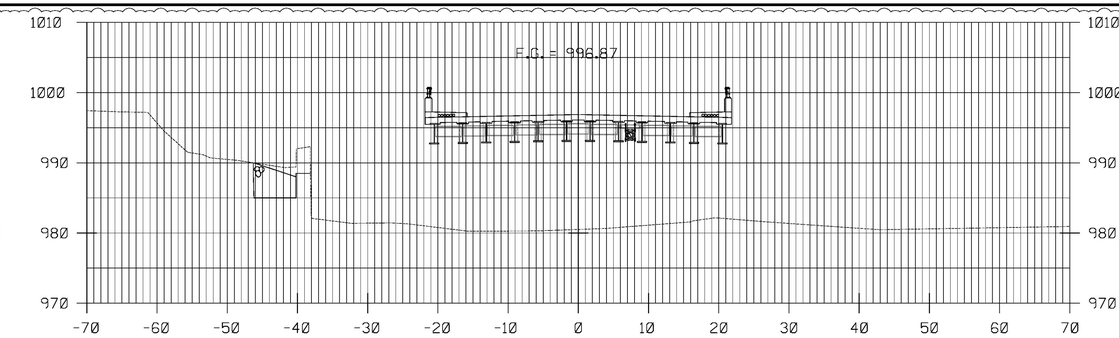


1

102+75
BEGIN BRIDGE
STA. 102+54.99

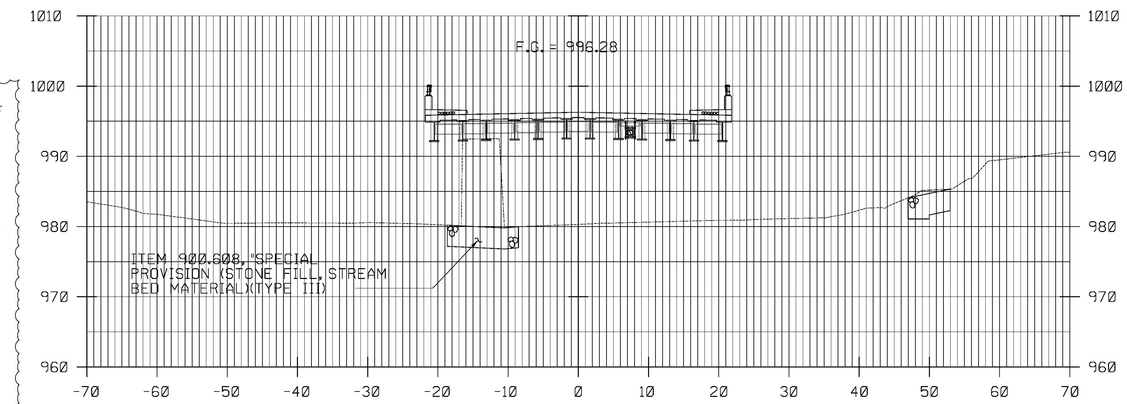ROADWAY CROSS SECTIONS
STA. 102+00 - 103+25

CALDERWOOD ENGINEERING, ETC.
STRUCTURAL ENGINEERING • DETAILING SERVICES
222 RIVER RD, RICHMOND, ME 04357 PH/FX (207)737-2007/(207) 737-2008

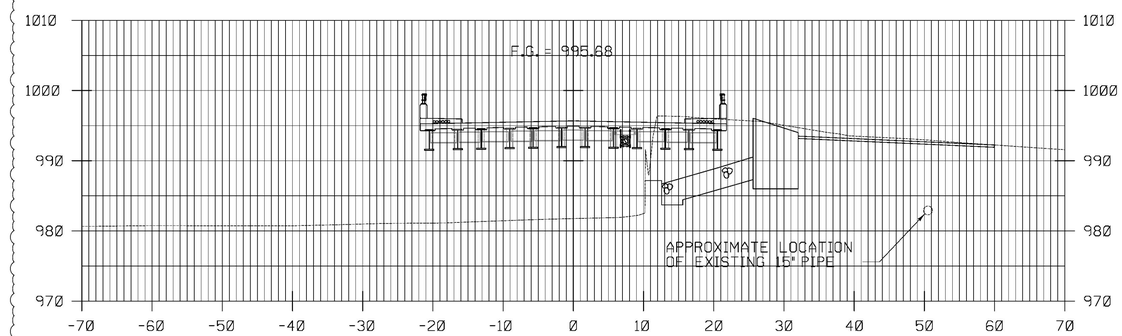PREPARED FOR:
COLD RIVER BRIDGES, LLC
CEE 16-16-COLDRIVERBRIDGES
01-CS-LUDLOW

STATE OF VERMONT
ERIC T. CALDERWOOD
NO. 8711
Structural I
LICENSED
PROFESSIONAL ENGINEER

8711
P.E. NUMBER

DATE:

| | BY | DATE |
|---|---|---|
| DESIGN-DETAILED | | |
| CHECKED-REVIEWED | | |
| REVISIONS 1 | TDC | MAR 2017 |
| REVISIONS 2 | | |
| REVISIONS 3 | | |
| REVISIONS 4 | | |
| FIELD CHANGES | | |

VE SUPER DESIGN
LUDLOW VT. BRF 025-1(42)

ROADWAY CROSS-SECTIONS (2 OF 4)

SHEET NUMBER
56
of 73

CALDERWOOD ENGINEERING
222 RIVER ROAD
RICHMOND, ME 04357
PH. (207) 737-2007 FAX (207) 737-2008