Vermont Agency of Transportation

RECEIVED

CK'D BY VHB OK'D BY TAS

February 8, 2017

RESUBMIT _____ APPROVED AS NOTED

BY T Sumner DATE 2/10/17

REV.	ALTERATION	DATE	BY

NOTE:
ARM TO BE FIELD DRILLED BY OTHERS.

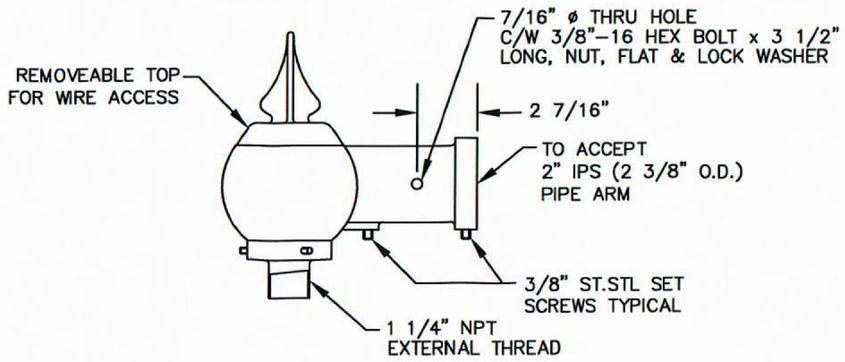

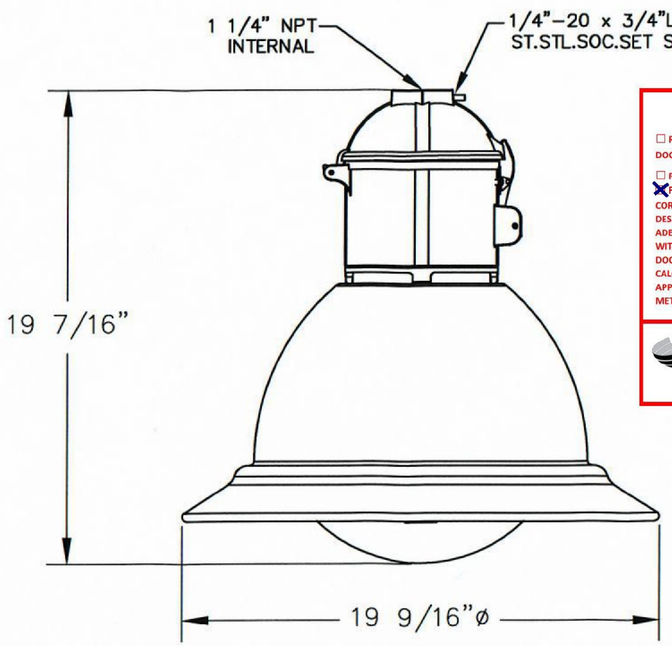

LUMINAIRE SPECIFICATIONS

CATALOGUE NO.:	K729–P4SA–III–60(SSL) –7030–120:277V–KPL20
QUANTITY:	
OPTICAL SYSTEM:	FLAT ARRAY, SAG LENS
IES CLASS.:	TYPE III
WATTAGE:	60W (7030 SERIES)
CCT/DIODE:	4000K/HE5
LIGHT SOURCE:	SOLID STATE LIGHTING
LINE VOLTAGE:	120:277V
PAINT:	TEXTURED FOREST GREEN
OPTIONS	KPL–20 LEVELING DEVICE

OPTIONS

QUICK DISCONNECT ☒
TERMINAL BLOCK ☐
} PLEASE SELECT ONE

Please specify "SMOOTH FOREST GREEN" to match the existing fixtures in the Town.

SUBMITTAL REVIEW

☐ REVIEWED AND APPROVED BUT ONLY FOR CONFORMANCE TO THE CONSTRUCTION CONTRACT DOCUMENTS

☐ REVISE AND RESUBMIT

☒ FURNISH AS CORRECTED

CORRECTIONS OR COMMENTS MADE DURING THIS REVIEW DO NOT RELIEVE THE CONTRACTOR OR HIS DESIGNER FROM COMPLIANCE WITH PROFESSIONAL REQUIRMENTS OR FOR RESPONSIBILITY FOR THE ADEQUACY OF THE SUBMITTAL INFORMATION. THIS CHECK IS ONLY FOR REVIEW OF GENERAL CONFORMANCE WITH INDUSTRY STANDARDS AND GENERAL COMPLIANCE WITH THE INFORMATION GIVEN IN THE CONTRACT DOCUMENTS. VHB HAS NOT CONDUCTED A DETAILED REVIEW OF THE SUBMITTAL AND HAS NOT PERFORMED CALCULATIONS OR ASSESSED THE ADEQUACY OF LOADS, DESIGN CRITERIA, QUANTITIES, DIMENSIONS, ETC. APPROVAL OF THE SUBMITTTAL DOES NOT CONSTITUTE VHB'S APROVAL OF ANY CONSTRUCTION MEANS, METHOEDS OR TECHNIQUES. THESE REMAIN THE RESPONSIBILITY OF THE CONTRACTOR.

vhb
40 IDX Drive
Building 100, Suite 200
South Burlington, VT 05403
802.497.6100

Job Number: BRF 025-1(42)
Reviewed By: E.F. LAWES
Date: Feb. 10, 2017

PPROVAL & DATE:

CUSTOMER ORDER No:	–
KING U.S. ORDER No:	–
KMFG. ORDER No:	–

King Luminaire • StressCrete • Est. 1953
STRESSCRETE GROUP

Manufacturing Locations:
Burlington, Ontario 1–800–268–7809
Northport, Alabama 1–800–435–6563
Atchison, Kansas 1–800–837–1024
Jefferson, Ohio 1–800–268–7809

PROJECT/CUSTOMER: LUDLOW, VT

DRAWN BY:	AT:	CHECKED BY:	DATE:	REVISION:
TASHI B.	SC1		05/26/16	

DRAWING TYPE:	DRAWING NUMBER:
CONCEPT DWG.	206A8733–1