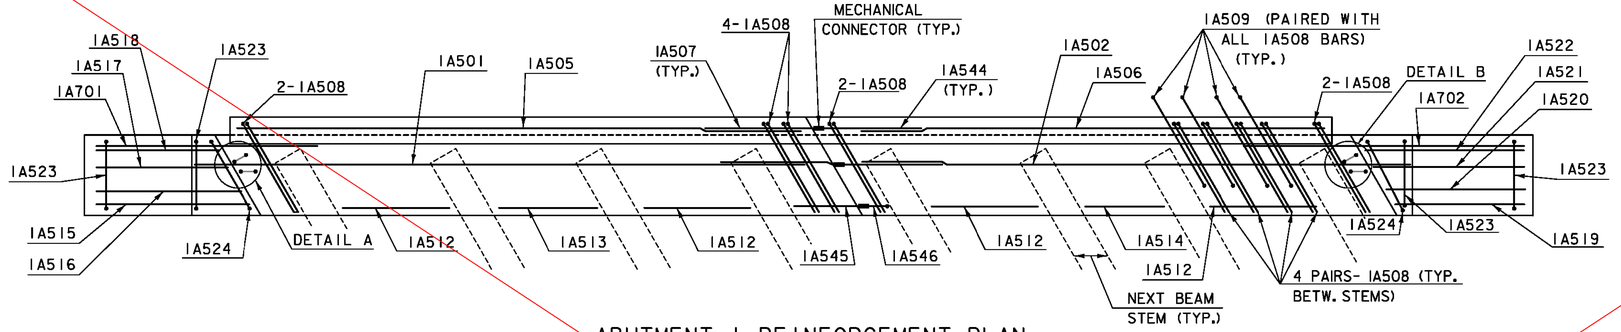

ABUTMENT 1 REINFORCEMENT PLAN

SCALE: N. T. S.

NOTE: PLAN VIEW IS FOR LAYOUT OF SPECIFIC BARS.
NOT ALL ABUTMENT BARS ARE SHOWN IN PLAN VIEW.

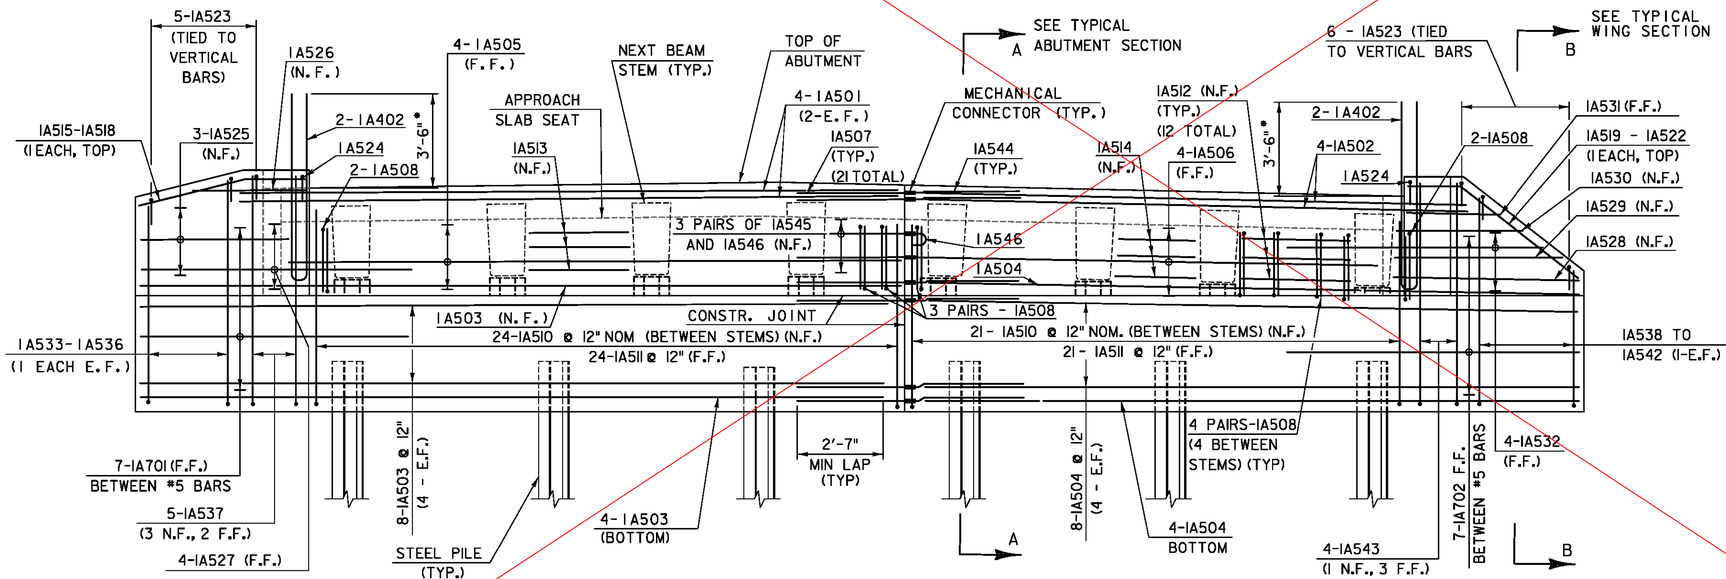

ABUTMENT 1 REINFORCMENT ELEVATION

SCALE: N. T. S.

NOTE: A509 BARS (APPROACH SLAB DOWELS) NOT SHOWN IN ELEVATION VIEW FOR CLARITY.

• TRIM 1A402 BARS IN FIELD AS NEEDED TO MAINTAIN COVER TO TOP OF CONCRETE BRIDGE RAILING END POST.

LEGEND

N. F. = NEAR FACE
F. F. = FAR FACE
E. F. = EACH FACE

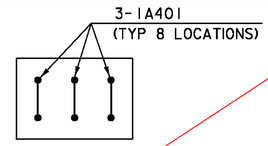

TYPICAL PEDESTAL REINFORCEMENT PLAN

SCALE: 1½" = 1'-0"

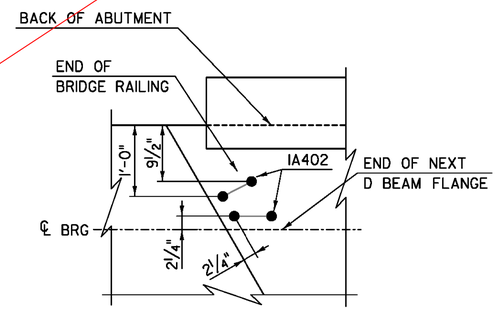

DETAIL A

SCALE: 1" = 1'-0"

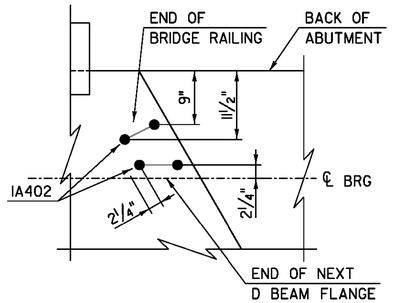

DETAIL B

SCALE: 1" = 1'-0"

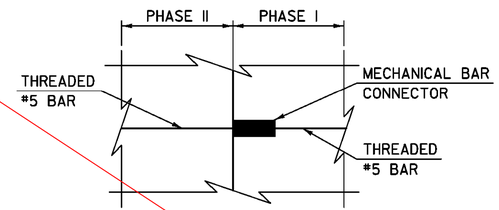

TYPICAL MECHANICAL CONNECTOR DETAIL

SCALE: 1½" = 1'-0"

PROJECT NAME:	ROCKINGHAM
PROJECT NUMBER:	BRF 0126(12)

T-Y LIN INTERNATIONAL

FILE NAME: z101072bdr_abut1R.dgn	PLOT DATE: 8/26/2014
PROJECT LEADER: R. HEBERT	DRAWN BY: B. CARTER
DESIGNED BY: S. KELLER	CHECKED BY: T. POULIN
ABUTMENT 1 REINFORCEMENT	SHEET 33 OF 69

SEE SHEET 33 VE