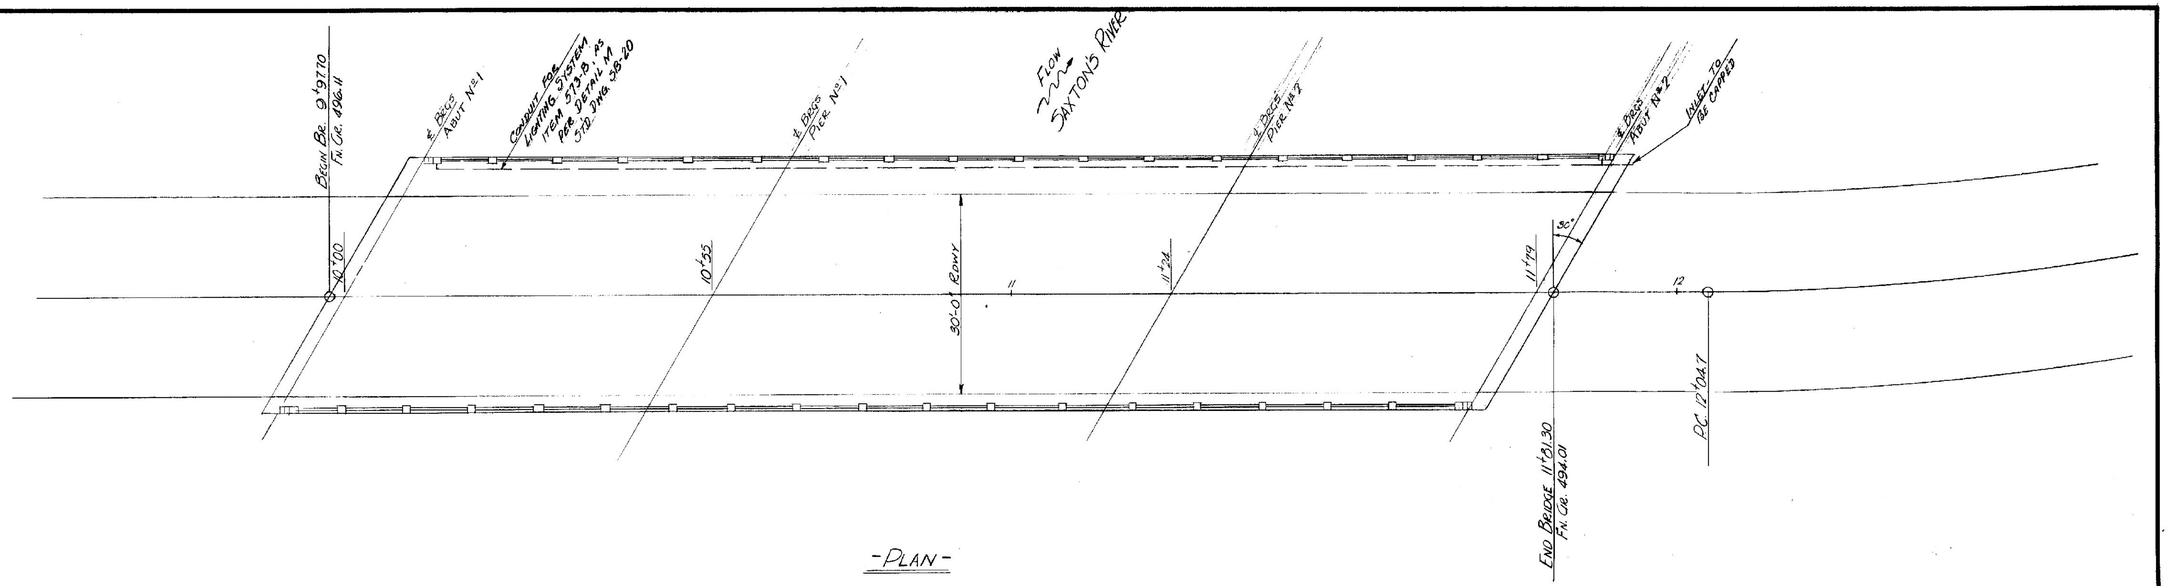

-PLAN-

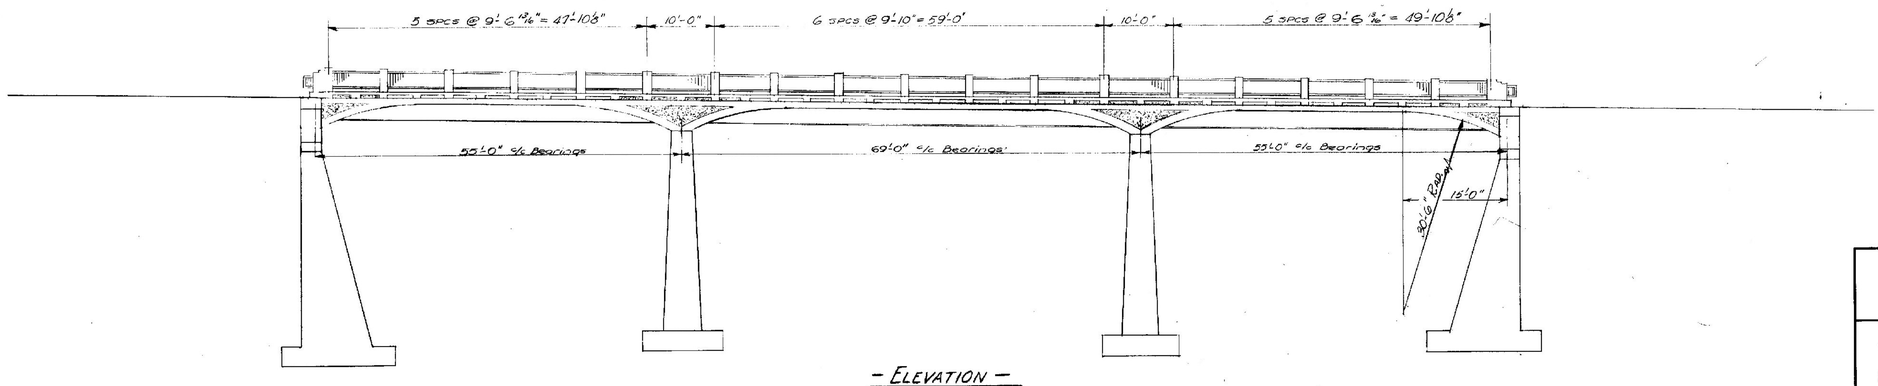

-ELEVATION-

FOR REFERENCE ONLY

STATE OF VERMONT
DEPARTMENT OF HIGHWAYS

TOWN OF ROCKINGHAM
ROAD NO. Vt. 121 BRIDGE NO. 11
BRIDGE PLAN & ELEVATION

SCALE 1"=10'-0"
SURVEYED BY POGAR
DRAWN BY JRJ CHECKED BY E.E.P.
PROJECT NO. 5156(3)
SHEET 8 OF 49