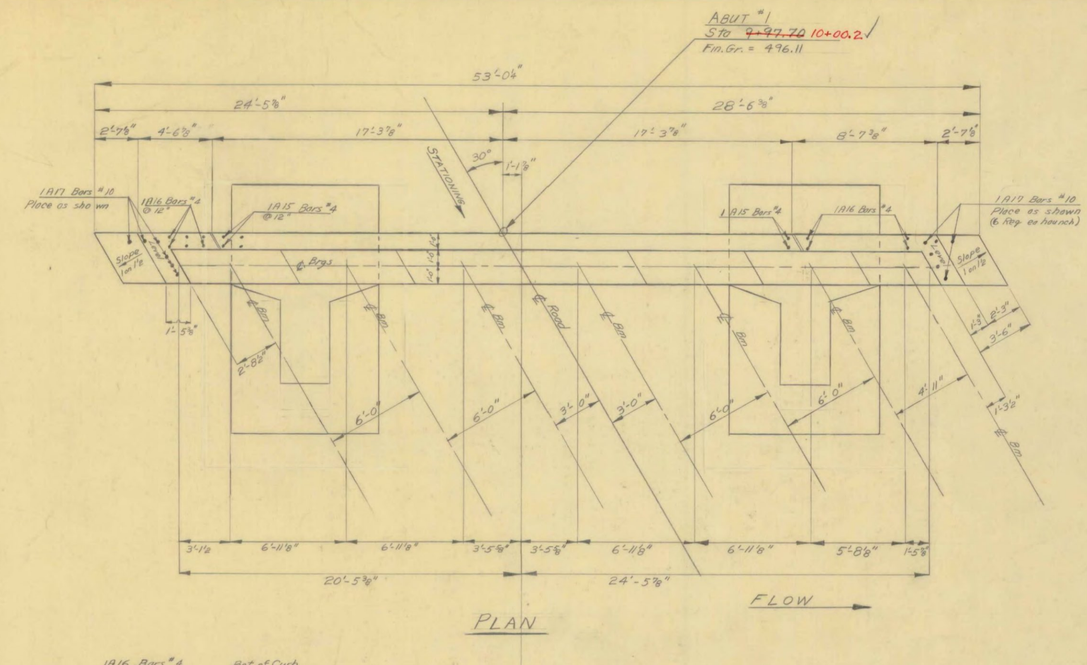

PLAN

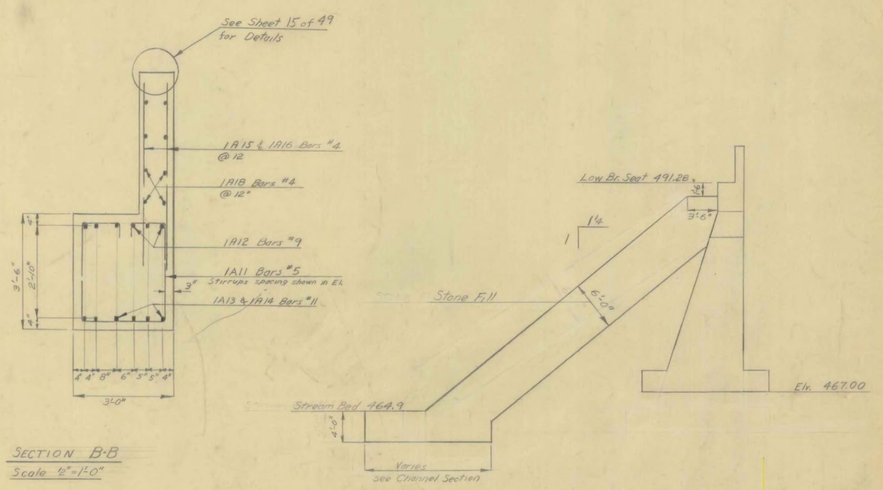

SECTION B-B
Scale ½"=1'-0"

TYPICAL SECTION
Scale ⅛"=1'-0"

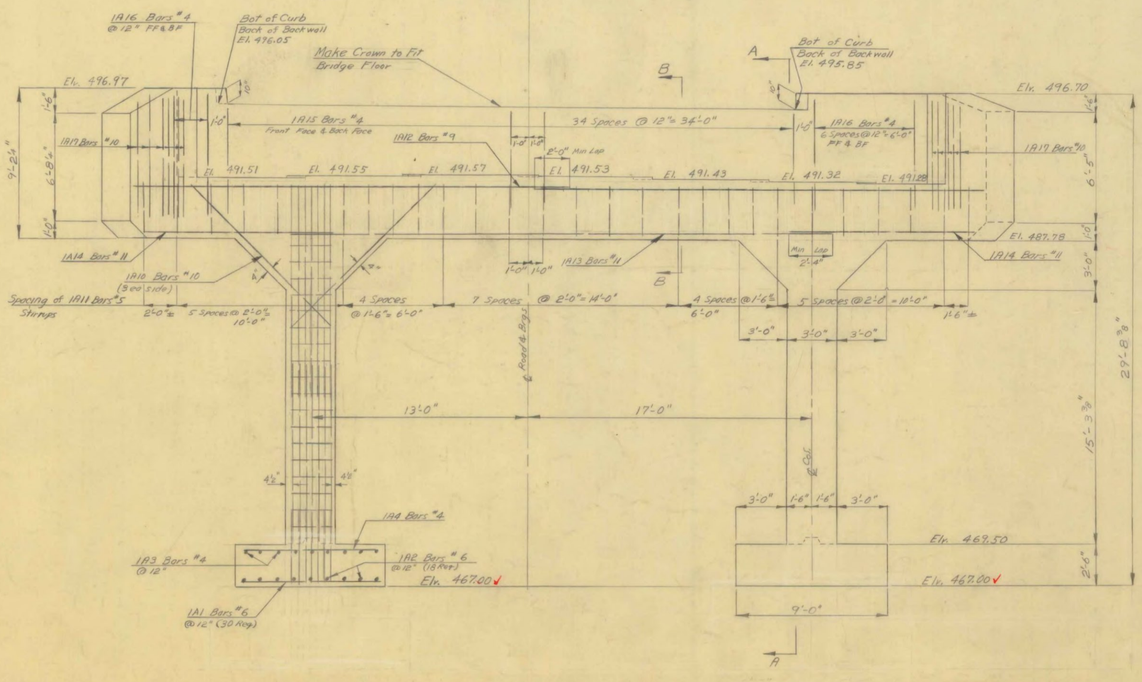

ELEVATION

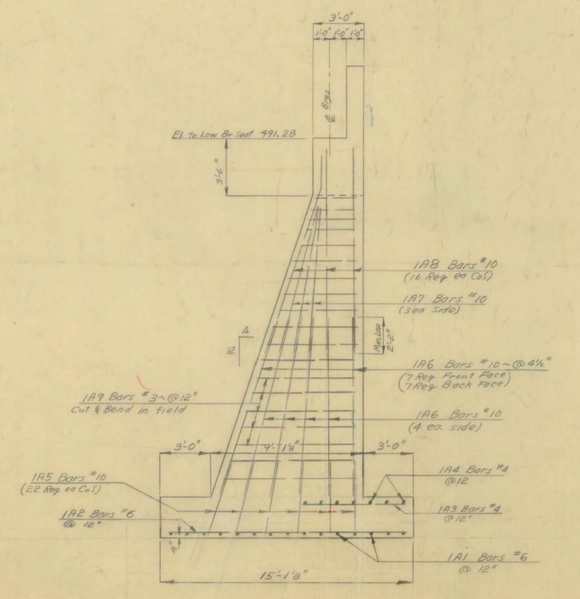

SECTION A-A

Note: All Laps 2'-0" except as noted.
Max. Foundation Pressure = 3.7 kips per sq. ft.

ESTIMATED QUANTITIES			
106C	Unclassified Channel Excavation	1,700	C.Y.
107	Structure Excavation	275	C.Y.
401B	Concrete Class B	86	C.Y.
521	Stone Fill	1,200	C.Y.

STATE OF VERMONT
DEPARTMENT OF HIGHWAYS

TOWN OF ROCKINGHAM
ROAD NO. Vt 121 BRIDGE NO. 11
DETAILS of ABUTMENT #1

SCALE 1/4"=1'-0" or as noted
SURVEYED BY Pegar
DRAWN BY C.F.H. CHECKED BY Des. W.H.H.
PROJECT NO. S 156 (3)
SHEET 9 OF 49

FOR REFERENCE ONLY