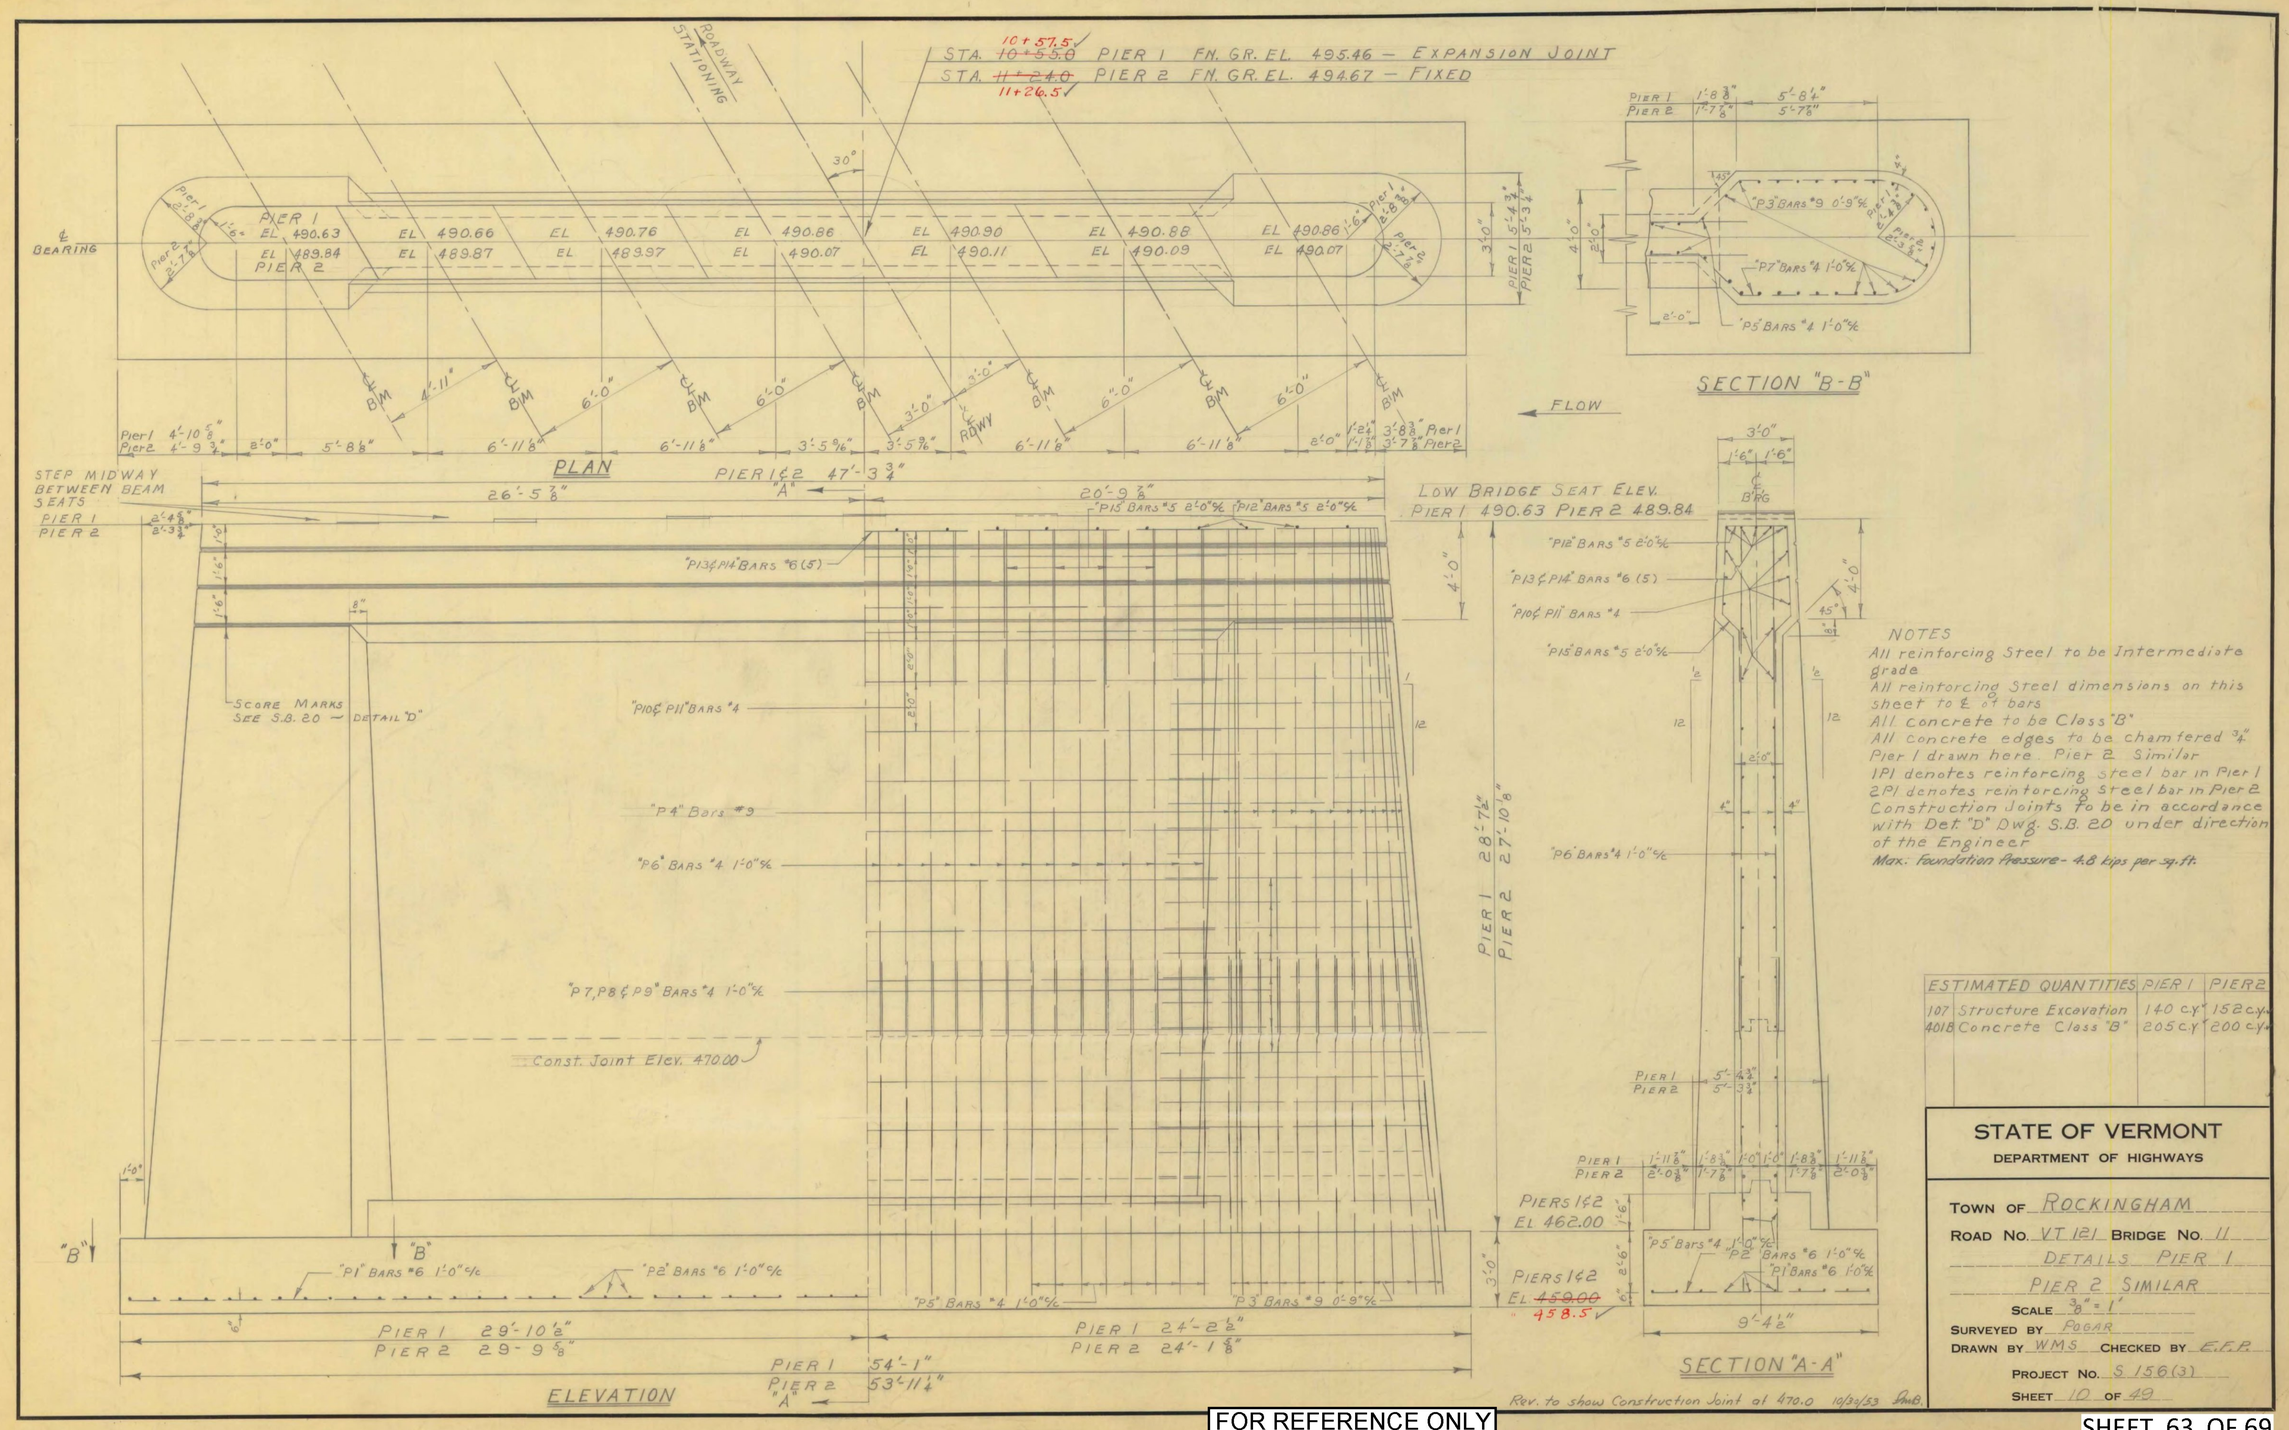

NOTES

All reinforcing Steel to be Intermediate grade
All reinforcing Steel dimensions on this sheet to ℄ of bars
All concrete to be Class "B"
All concrete edges to be chamfered 3/4"
Pier 1 drawn here. Pier 2 Similar
1P1 denotes reinforcing steel bar in Pier 1
2P1 denotes reinforcing steel bar in Pier 2
Construction Joints to be in accordance with Det "D" Dwg. S.B. 20 under direction of the Engineer

ESTIMATED QUANTITIES		PIER 1	PIER 2
107	Structure Excavation	140 c.y.	152 c.y.
401B	Concrete Class "B"	205 c.y.	200 c.y.

STATE OF VERMONT
DEPARTMENT OF HIGHWAYS

TOWN OF ROCKINGHAM
ROAD NO. VT 121 BRIDGE NO. 11
DETAILS PIER 1
PIER 2 SIMILAR
SCALE 3/8" = 1'
SURVEYED BY POGAR
DRAWN BY WMS CHECKED BY E.F.P.
PROJECT NO. S 156(3)
SHEET 10 OF 49

FOR REFERENCE ONLY