STATION	POSITION	TYPE	QUANTITY (SY)
ELMORE			
191+60	LT	GRAVEL	13.5
193+22	LT	FIELD	3.4
196+43	LT	GRAVEL	13.1
200+89	LT	GRAVEL	10.7
210+71	LT	GRAVEL	8.4
216+72	LT	GRAVEL	21.2
221+88	LT	GRAVEL	15.2
222+68	RT	WOODS	4.9
225+26	LT	GRAVEL	12.2
235+26	LT	GRAVEL	12.1
239+14	LT	FIELD	5.5
243+84	LT	FIELD	3.5
244+31	RT	GRAVEL	60.9
254+97	RT	FIELD	6.3
255+63	LT	FIELD	4.5
258+63	RT	GRAVEL	12.5
263+29	RT	FIELD	4.5
268+11	LT	GRAVEL	32.0
269+63	LT	GRAVEL	14.5
273+07	LT	GRAVEL	13.2
275+28	LT	GRAVEL	12.3
276+10	RT	FIELD	6.8
280+26	RT	GRAVEL	6.4
281+61	RT	FIELD	4.6
285+96	LT	GRAVEL	7.9
286+61	RT	GRAVEL	10.6
294+80	LT	GRAVEL	20.3
295+41	RT	GRAVEL	9.0
298+90	RT	GRAVEL	10.4
301+41	RT	GRAVEL	11.4

STATION	POSITION	TYPE	QUANTITY (SY)
307+11	RT	GRAVEL	7.2
308+43	RT	PAVED	7.9
312+80	RT	GRAVEL	6.6
314+00	LT	GRAVEL	28.9
319+07	RT	GRAVEL	35.6
321+94	LT	WOODS	3.8
326+84	LT	GRAVEL	7.8
329+72	RT	FIELD	4.5
331+80	LT	PAVED	12.3
333+51	LT	GRAVEL	10.4
336+09	LT	PAVED	10.8
340+22	RT	GRAVEL	6.9
345+52	RT	PAVED	7.4
347+38	RT	PAVED	11.4
349+05	RT	FIELD	2.9
353+26	LT	GRAVEL	11.4
355+82	RT	PAVED	59.1
355+82	LT	PAVED	171.7
357+13	RT	PAVED	14.5
359+83	LT	GRAVEL	15.6
360+50	LT	GRAVEL	9.2
362+01	RT	GRAVEL	14.5
362+19	LT	PAVED	9.7
365+14	RT	GRAVEL	5.3
369+22	RT	GRAVEL	8.6
372+44	RT	FIELD	2.9
372+95	RT	GRAVEL	11.1
373+90	LT	PAVED	22.0
374+84	RT	GRAVEL	9.6
376+92	RT	GRAVEL	15.5

STATION	POSITION	TYPE	QUANTITY (SY)
379+37	RT	FIELD	3.6
390+03	RT	FIELD	4.4
391+75	RT	FIELD	3.4
393+13	RT	GRAVEL	12.9
393+99	LT	WOODS	2.6
395+20	RT	GRAVEL	14.5
404+89	LT	WOODS	2.8
412+72	LT	PAVED	13.5
416+53	LT	GRAVEL	15.5
MORRISTOWN			
A +86	LT	GRAVEL	10.9
A 5+41	RT	GRAVEL	20.0
A 8+14	LT	FIELD	2.5
A 9+74	LT	GRAVEL	11.4
A 17+06	LT	GRAVEL	51.7
A 17+32	RT	GRAVEL	12.9
A 25+85	LT	WOODS	2.0
A 26+26	RT	GRAVEL	20.3
A 27+85	RT	GRAVEL	15.9
A 37+47	RT	PAVED	22.9
A 38+41	RT	GRAVEL	7.0
A 40+92	RT	GRAVEL	11.4
A 41+96	LT	GRAVEL	6.6
A 43+69	LT	FIELD	2.3
A 46+40	RT	GRAVEL	19.4
A 47+29	RT	GRAVEL	15.2
A 48+29	RT	GRAVEL	13.7
A 57+90	RT	GRAVEL	8.2
A 58+33	RT	GRAVEL	6.1
A 59+60	RT	PAVED	11.1
A 60+61	RT	PAVED	11.9

STATION	POSITION	TYPE	QUANTITY (SY)
A 62+45	RT	PAVED	11.4
A 63+70	RT	GRAVEL	23.0
A 66+21	RT	GRAVEL	17.9
A 69+17	LT	GRAVEL	17.6
A 76+18	LT	PAVED	16.7
A 77+53	LT	GRAVEL	10.3
A 81+54	RT	PAVED	6.6
A 81+92	LT	PAVED	31.5
A 82+41	RT	PAVED	8.9
A 85+21	LT	PAVED	19.6
A 89+38	RT	GRAVEL	8.0
A 90+32	RT	GRAVEL	10.3
A 91+57	RT	FIELD	3.8
A 92+58	LT	FIELD	3.6
A 93+87	LT	PAVED	30.4
A 94+15	RT	FIELD	3.9
A 95+32	RT	GRAVEL	13.6
A 101+09	RT	FIELD	2.6
A 102+61	RT	GRAVEL	8.4
A 106+71	LT	GRAVEL	8.8
111+71	RT	PAVED	7.4
113+08	RT	PAVED	15.7
113+42	LT	GRAVEL	7.1
A 114+34	LT	PAVED	12.0
		SUBTOTAL	1572.6
		ROUNDING	77.4
		TOTAL	1650.0

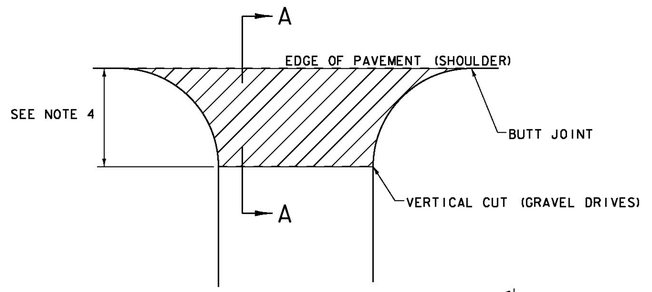

PLAN

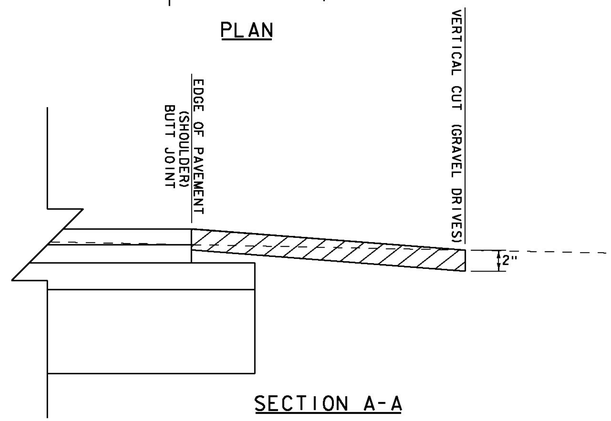

SECTION A-A

HANDWORK DETAILS FOR DRIVES - GRAVEL DRIVES

VT ROUTE 12

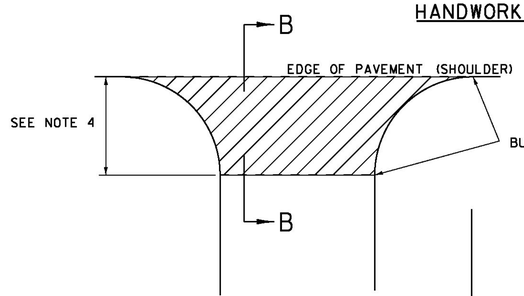

PLAN

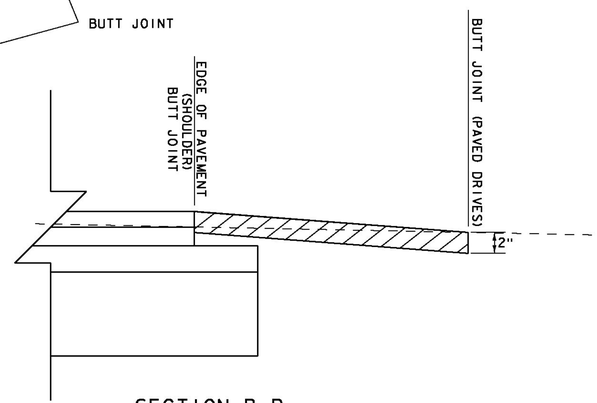

SECTION B-B

HANDWORK DETAILS FOR DRIVES - PAVED DRIVES

VT ROUTE 12

NOTES:

1. PAVING LIFT NOT TO EXCEED 2" (50mm)

2. THE COST OF PLACING SUBBASE MATERIAL, CLEANING EXISTING PAVED SURFACES, INCLUDING POWER EQUIPMENT, AND FOR FILLING JOINTS, CRACKS AND HOLES WILL NOT BE PAID DIRECTLY BUT WILL BE CONSIDERED INCIDENTAL TO ITEM 900.675 "SPECIAL PROVISION (HAND-PLACED BITUMINOUS CONCRETE MATERIAL, DRIVES)".

3. EXCAVATION OR FILL NEEDED TO ACHIEVE PROPER DRIVE SLOPES WILL NOT BE PAID DIRECTLY BUT WILL BE CONSIDERED INCIDENTAL TO ITEM 900.675 "SPECIAL PROVISION (HAND-PLACED BITUMINOUS CONCRETE MATERIAL, DRIVES)".

4. FIELD DRIVES 2'-0"; RESIDENTIAL AND COMMERCIAL DRIVES 4'-0"; OR AS DIRECTED BY THE ENGINEER.

LEGEND

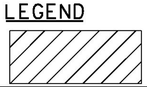

DETAILS ARE NOT TO SCALE

ITEM 900.675 "SPECIAL PROVISION (HAND-PLACED BITUMINOUS CONCRETE MATERIAL, DRIVES)"

HANDWORK DETAILS FOR DRIVES

PROJECT NAME: ELMORE-MORRISTOWN
PROJECT NUMBER: STP 2937 (1)

FILE NAME: z11c310.dgn
PROJECT LEADER: C. LATHROP
DESIGNED BY: S. LAMPHERE
PLOT FILE: z11c310_21.i

PLOT DATE: 3/3/14
DRAWN BY: S. LAMPHERE
CHECKED BY: C. LATHROP
SHEET 21 OF 194