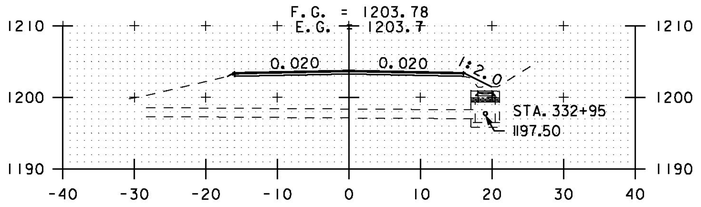

333+00

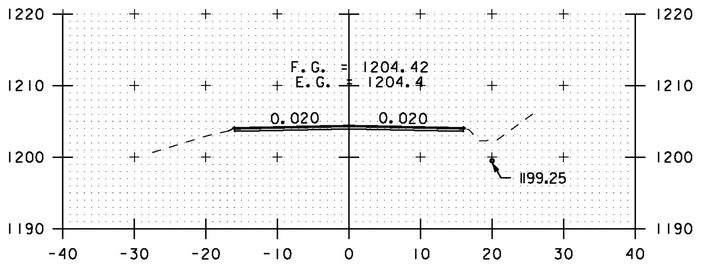

332+50

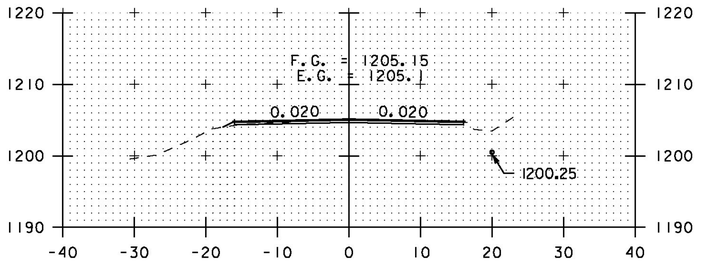

332+00

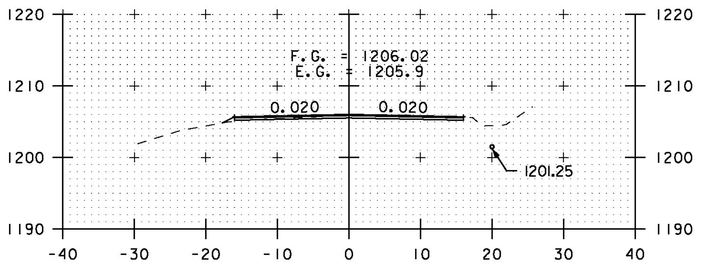

331+50

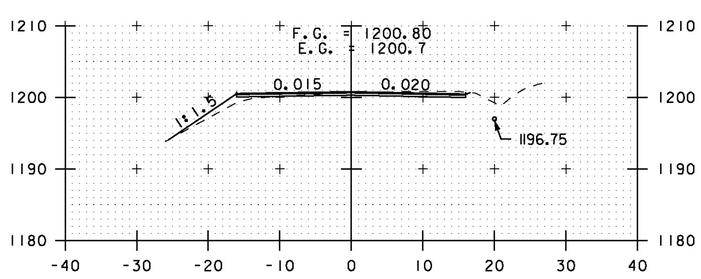

335+00

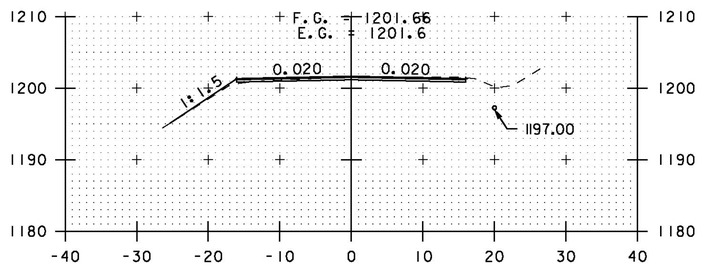

334+50

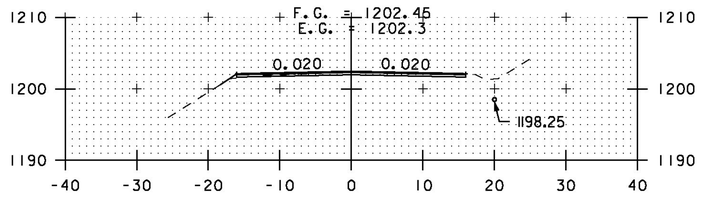

334+00

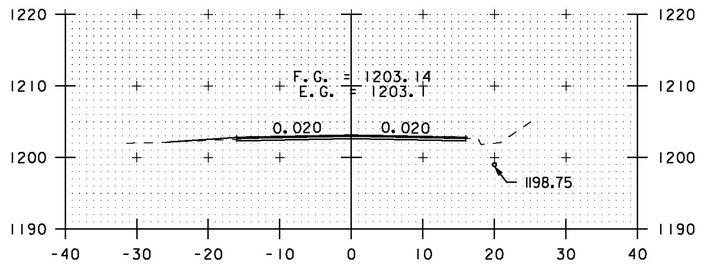

DRIVE LT
333+50

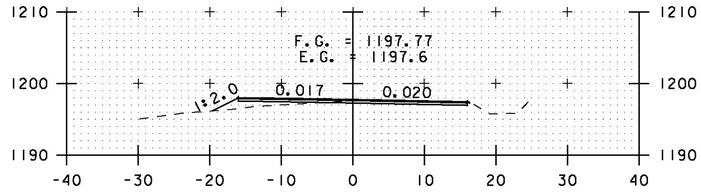

337+00

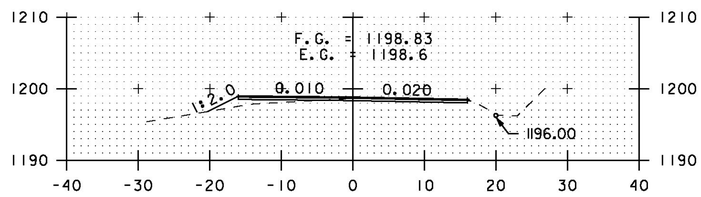

336+50

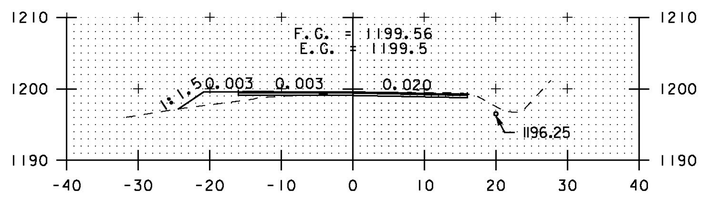

DRIVE LT
336+00

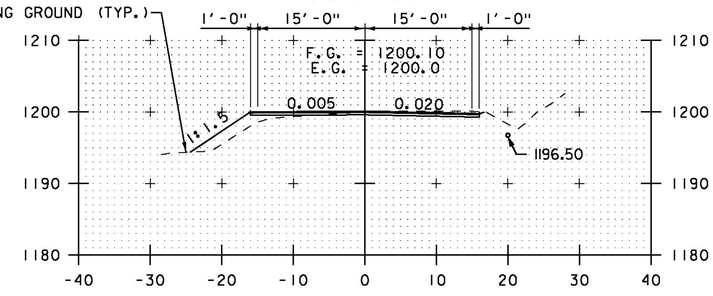

335+50

STA. 331+50 TO STA. 337+00

SCALE 1" = 10'-0
10 0 10

CROSS SECTION SHEET 27

PROJECT NAME: ELMORE-MORRISTOWN
PROJECT NUMBER: STP 2937 (1)

FILE NAME: z11c310.dgn
PROJECT LEADER: C. LATHROP
DESIGNED BY: S. LAMPHERE
PLOT FILE: z11c310_155.i

PLOT DATE: 3/3/14
DRAWN BY: B. MARTIN
CHECKED BY: C. LATHROP