Vermont Agency of Transportation

RECEIVED

ON: July 3, 2013

and Checked for

CONFORMANCE

BY: Rob Young DATE: 07/08/13

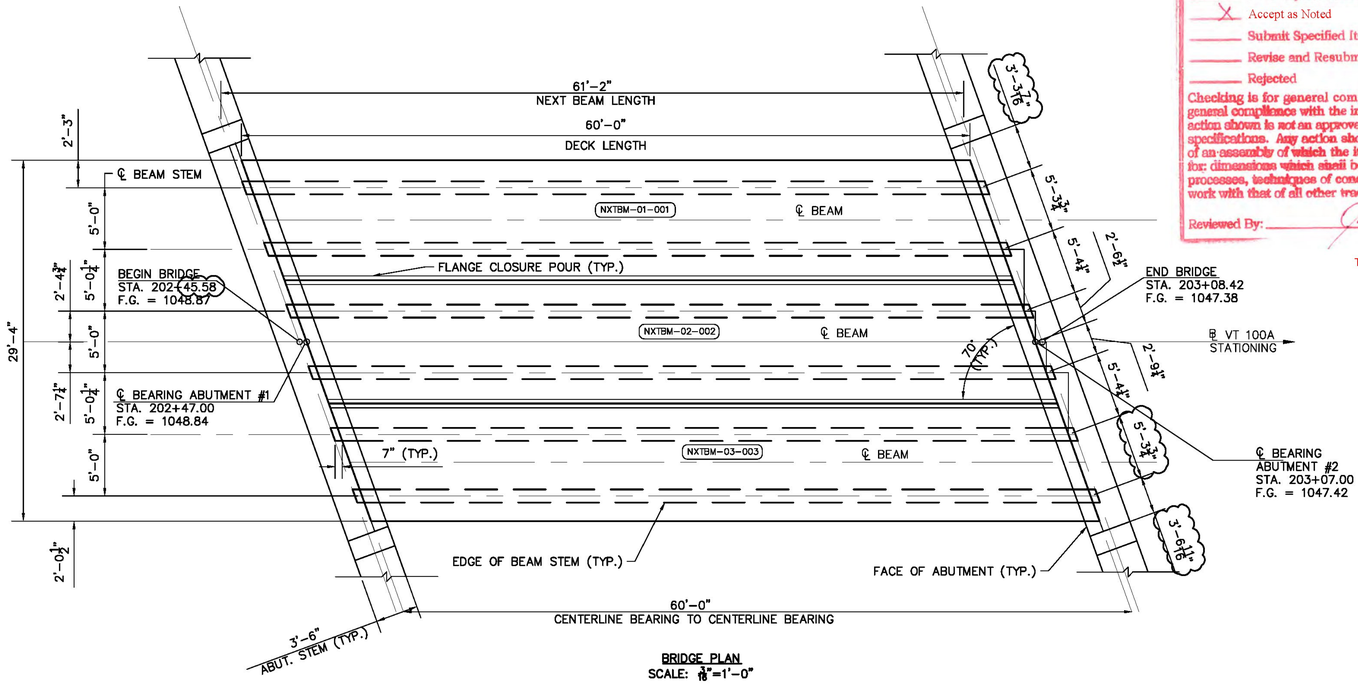

BRIDGE PLAN
SCALE: 3/16"=1'-0"

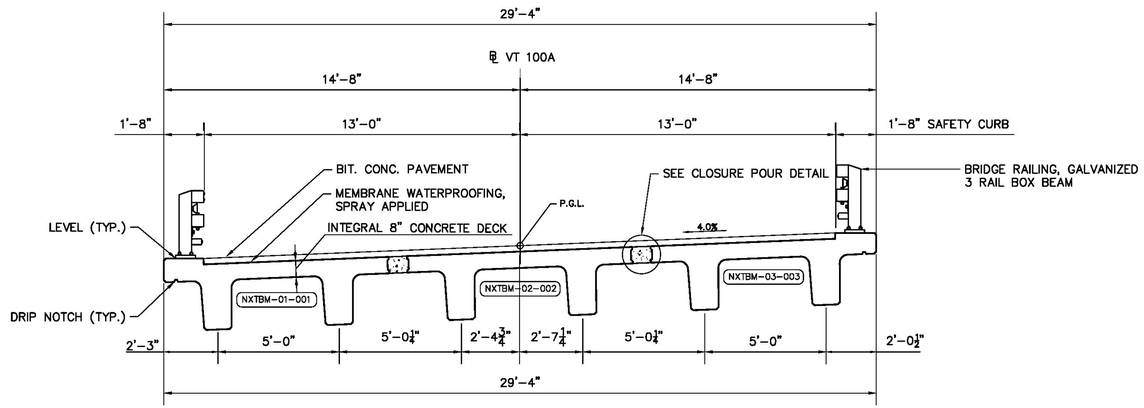

BRIDGE TYPICAL SECTION
SCALE: 3/8" = 1'-0"

No Exception Taken
X Accept as Noted
Submit Specified Item
Revise and Resubmit as Noted
Rejected

T-Y-LIN INTERNATIONAL

Checking is for general compliance with the design concept of the project and general compliance with the information given in the contract documents only. Any action shown is not an approval and is subject to the requirements of the plans and specifications. Any action shown on a specific item shall not indicate the checking of an assembly of which the item is a component. Contractor is solely responsible for: dimensions which shall be confirmed and correlated at the job site, fabrication processes, techniques of construction, safety precautions and coordination of its work with that of all other trades and the satisfactory performance of its work.

Reviewed By: _____ Date: July 8, 2013

There is no need to resubmit these fabrication drawings.

NOTES:

1. SHOP DRAWINGS WERE DEVELOPED USING THE FOLLOWING RESOURCES FOR THE CONTRACT: VT100A REPLACEMENT OF BRIDGE OVER PINNEY HOLLOW BROOK, PLYMOUTH, VT. BRIDGE NO. 47 PREPARED BY TYLIN. PROJECT NO ER BRS 0149(5)
2. IF THERE IS ADDITIONAL INFORMATION PERTINENT TO THE FABRICATION AND INSTALLATION OF THESE UNITS THAT IS NOT CONTAINED WITHIN THE RESOURCES LISTED ABOVE, IT SHALL BE BROUGHT TO THE ATTENTION OF DAILEY PRECAST LLC. AND EIV TECHNICAL SERVICES OF ALL LIABILITIES ARISING FROM ERRORS OR OMISSIONS RELATED TO THE OMITTED INFORMATION.
3. VOIDS AT LIFTER POCKETS SHALL BE FILLED WITH APPROVED NON-SHRINK GROUT ONCE BEAMS ARE IN PLACE. (NOT BY DP)
4. TOLERANCES SHALL BE IN ACCORDANCE WITH PCI TOLERANCE MANUALS (MNL-135 & MNL-116)

CONSTRUCTION SET DATE: 06/28/2013	
SHEET NAME: ERECTION PLAN	
REVISION NO.	REVISION DATE

Dailey PRECAST
WILLIAM E. DAILEY PRECAST, LLC
295 AIRPORT ROAD
SHAFTSBURY, VT 05262
TEL: 802.442.4418 FAX: 802.442.0738

STATE OF VERMONT · CHARLES H. SWANGO · No. 8126 Structural · LICENSED PROFESSIONAL ENGINEER

EIV TECHNICAL SERVICES
55 LEROY ROAD, WILLISTON, VT 05495
TEL: (802) 497-3653 FAX: (802) 497-3656

DATE: JUNE 2013 PROJECT # E1729
DRAWN BY: LKW/CN CHECKED BY: CHS

STATE OF VERMONT AGENCY OF TRANSPORTAION

PLYMOUTH, VERMONT
PROJECT NO: ER BRS 0149(5)

SHEET 1 OF 9