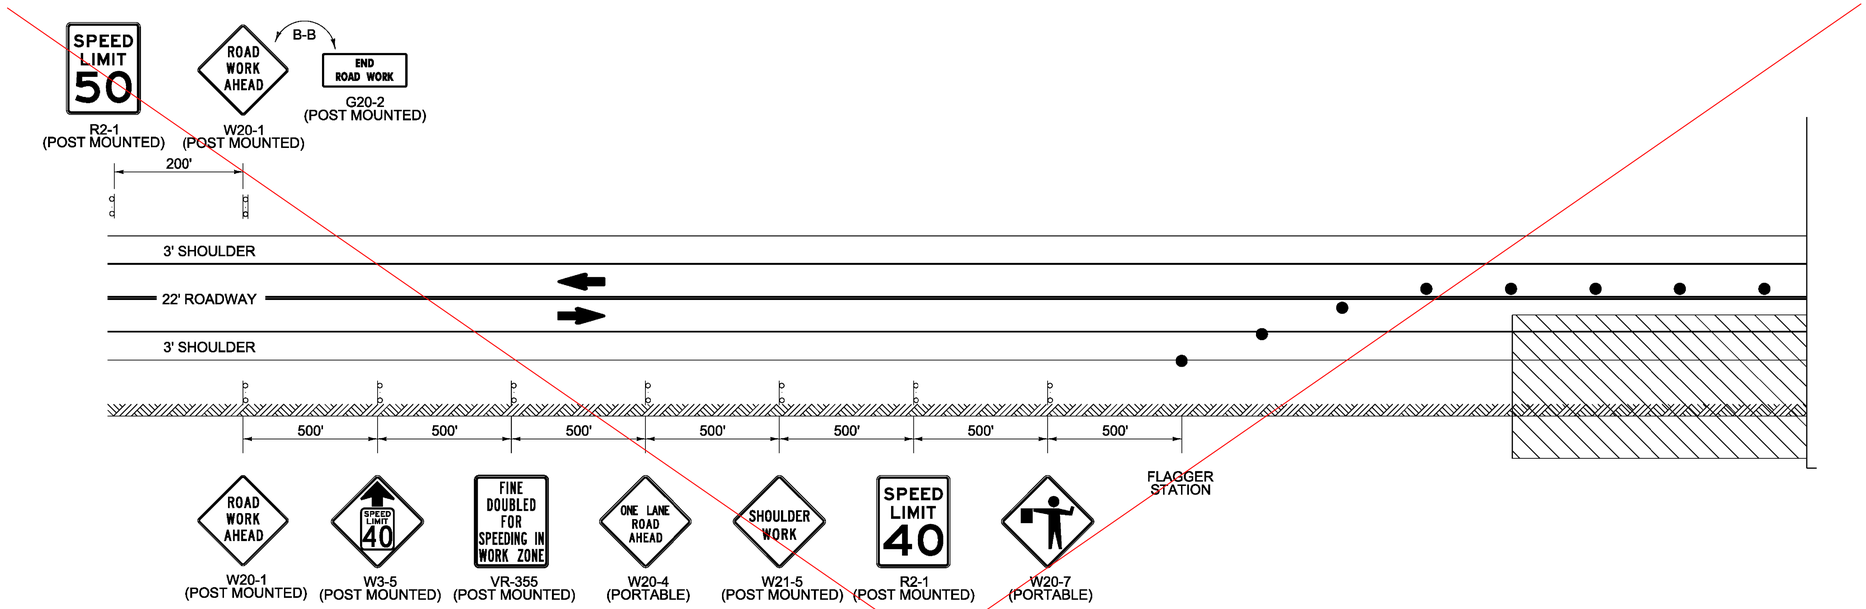

WORK ZONE B – ONE-WAY ALTERNATING TRAFFIC

(NOT TO SCALE)

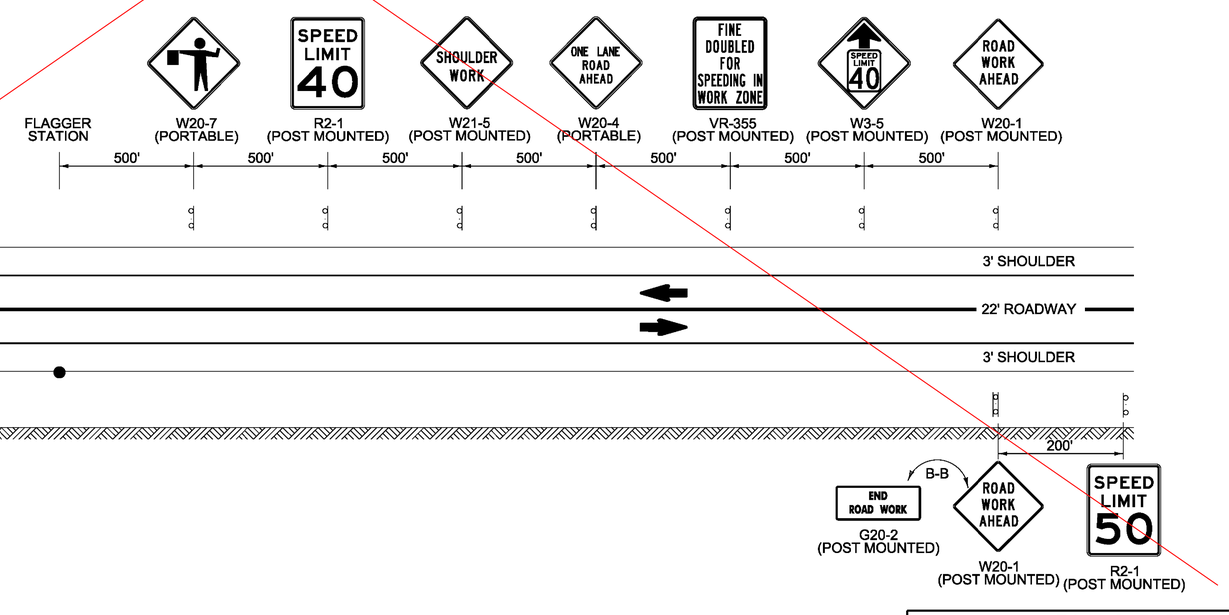

DIRECTION OF TRAFFIC

TRAFFIC CONTROL DEVICE

TEMPORARY TRAFFIC BARRIER

WORK AREA

WORK ZONE B – ONE-WAY ALTERNATING TRAFFIC

(NOT TO SCALE)

WORK ZONE A SIGNS WERE PLACED TO COVER BOTH LOCATIONS

PROJECT NAME: TOWNSHEND	
PROJECT NUMBER: STP 015-1(22)	
FILE NAME: dllb050frm.dgn	PLOT DATE: 1/9/2015
PROJECT LEADER: K. UPMAL	DRAWN BY: C. LEACH
DESIGNED BY: C. LEACH	CHECKED BY: B. KIPP
CONSTRUCTION APPROACH SIGNING SHEET 2	SHEET 31 OF 34