FDN INFO		SHIP	BILL OF MATERIAL						JOB NO. 529-1	DRAWING NO. 10	REV.
PAGE	LINE	MARK	QTY	MARK	MATERIAL	LENGTH FT	LENGTH INCHES		REMARKS	WT	PROCUREMENT NOTES
		10G2C	1		GIRDER					23076	
1	J		1	wa	PL $\frac{5}{8}$x48	85	$4\frac{3}{4}$	M270-50WT2		8718	
1	G		1	ta	PL $1\frac{1}{4}$x16	85	$4\frac{3}{16}$	M270-50WT2		5808	
1	E		1	ba	PL $1\frac{3}{4}$x16	85	$4\frac{5}{16}$	M270-50WT2		8133	
2	L		2	x1k	PL $\frac{7}{8}$x$7\frac{1}{2}$	4	0			85	
2	M		4	x1m	PL $\frac{1}{2}$x5	4	0			34	
2	M		2	x1n	PL $\frac{1}{2}$x5	4	0			34	
2	M		1	x1p	PL $\frac{1}{2}$x5	4	0			34	

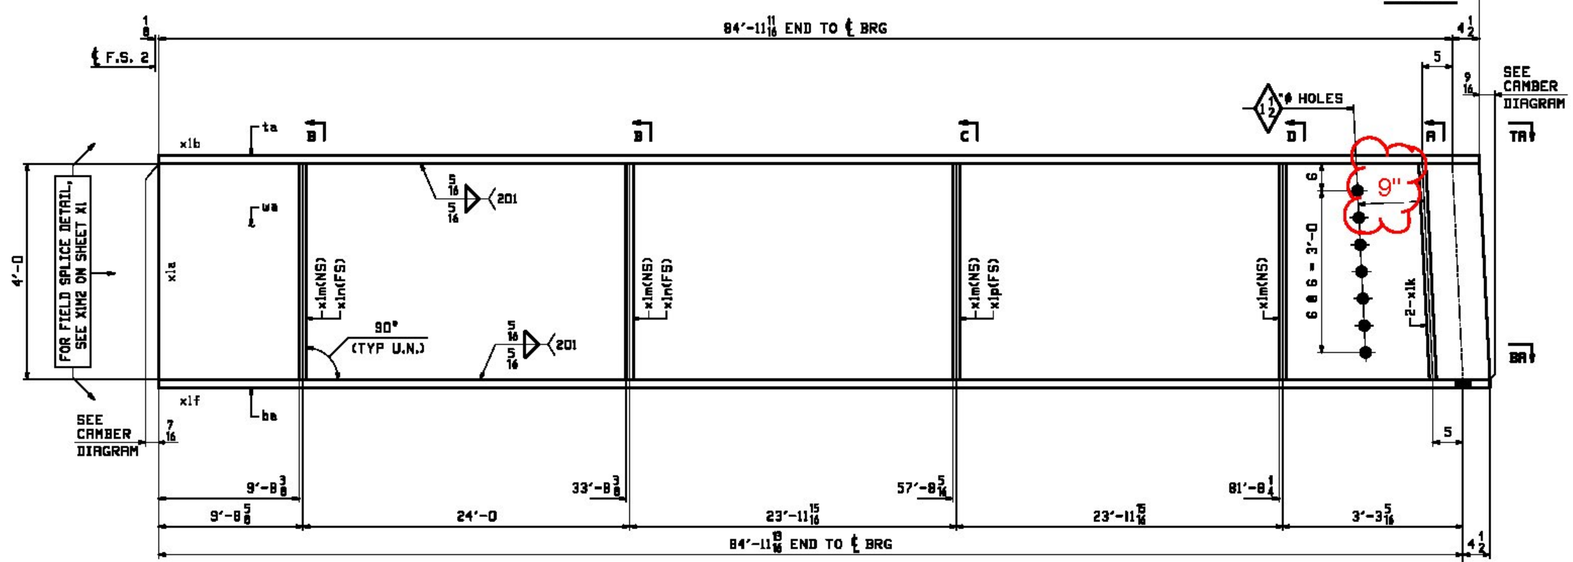

ONE ~ GIRDER ~ 10G2C

NOTES:
1. FOR GENERAL NOTES SEE SHEET GN1.
2. FOR FIELD SPLICE DETAILS SEE SHEET X1.
3. FOR GIRDER STANDARD DETAILS SEE SHEET X1.
4. FOR CAMBER & FLANGE DIAGRAM SEE SHEET C1.
5. T2 - DENOTES CHARPY V-NOTCH TESTING REQUIRED.

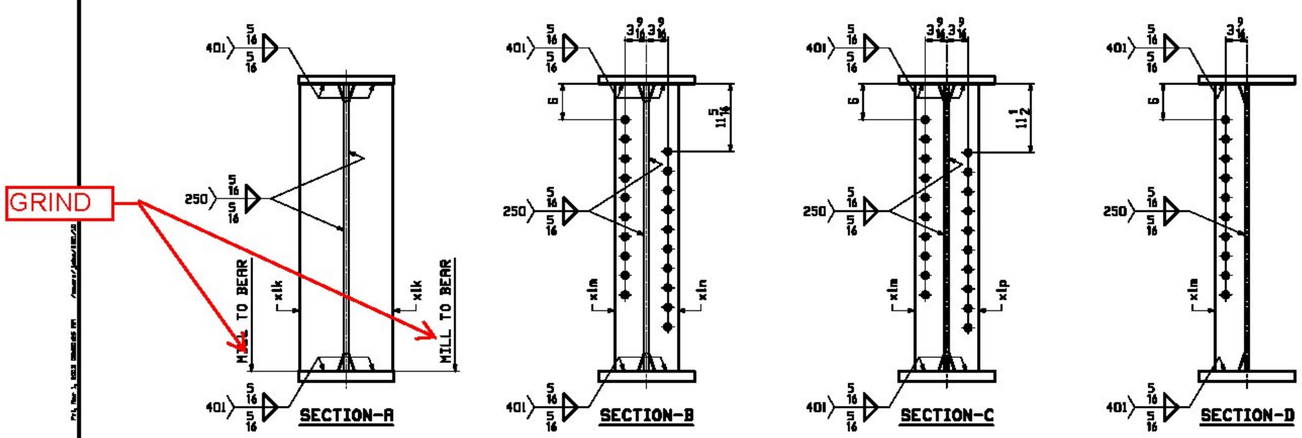

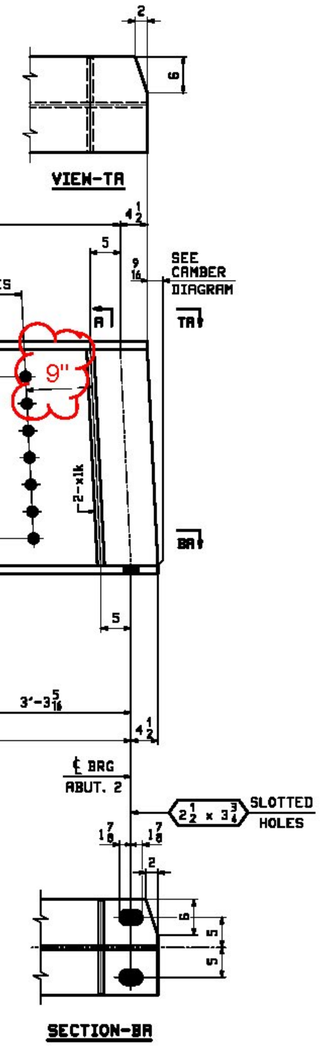

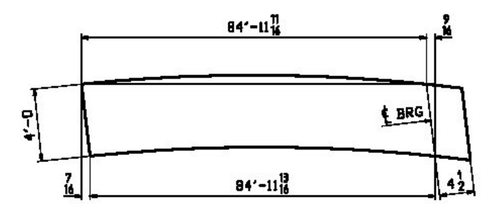

ORIENTATION DIAGRAM

REV.	DATE	REMARKS	DWN	CHK	APVL	SHOP
0						

MATERIAL:	SURFACE PREP. & PAINT:	HOLES:	SHOP BOLTS:
M270-50W	SEE GN1	15/16" ϕ U.N.	NONE

DESCRIPTION: GIRDER ~ 10G2C

CASCO BAY STEEL STRUCTURES, INC.
1 WALLACE AVE. PHONE (207) 780-6722
SOUTH PORTLAND, ME 04106 FAX. (207) 780-6726

STRUCTURE: VT 100 OVER WARDSBORO BROOK BRIDGE NO 78 WINDHAM COUNTY	DRAWN: EEO	DATE: 02/04	
	CHKD: DBH	DATE: 02/27	
LOCATION: TOWN OF JAMAICA, VT	JOB NO. 529-1	DWG NO. 10	
PROJ NO. ER-BRF 013-1(16)			
CUSTOMER: T. BUCK CONSTRUCTION		REV. △	

Vermont Agency of Transportation
RECEIVED
CK'D BY GMU/JWC OK'D BY GG
March 6, 2013
RESUBMIT NO Approved AsNoted
BY KMH DATE 04/02/13