FDM INFO		SHIP	BILL OF MATERIAL					JOB NO.	DRAWING NO.	REV.
								529-1	14	
PAGE	LINE	MARK	QTY	MARK	MATERIAL	LENGTH FT	LENGTH INCHES	REMARKS	WT	PROCUREMENT NOTES
		14AB1	16		ANCHOR BOLT ASSEMBLY				28	
3	B		16	a14	2 ø HCD	2	11	THRD = 19-1/2" M449	14	
3	C		48	b14	2 ø HHN			M563	3	
3	D		32	c14	PL $\frac{3}{8}$x5	0	5	M270-50W	3	
					LEVELING PLATE					
3	E	14LP1	8		PL $1\frac{1}{4}$x6	1	4	M270-50W	34	

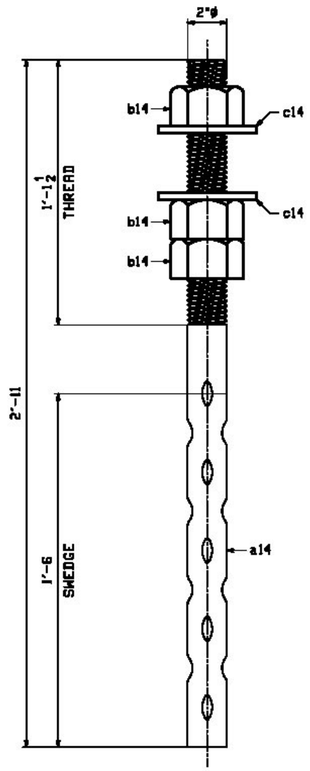

16 ~ ANCHOR BOLTS ~ 14AB1

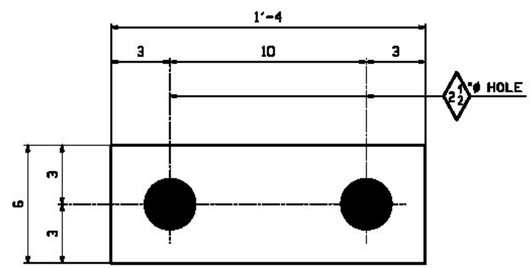

8 ~ LEVELING PLATE ~ 14LP1

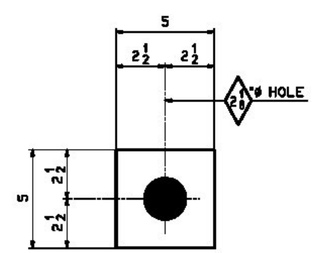

32 ~ PLATE WASHER ~ c14

Vermont Agency of Transportation
RECEIVED
CK'D BY GML/JWC OK'D BY GG
March 6, 2013
RESUBMIT Approved
BY KMH DATE 03/18/13

NOTES:
1. FOR GENERAL NOTES SEE DRAWING GN1.

REV.	DATE	REMARKS	DWN	CHK	APVL	SHOP
0						

MATERIAL:	SURFACE PREP. & PAINT:	HOLES:	SHOP BOLTS:
AS NOTED	NONE	AS NOTED	NONE

DESCRIPTION: ANCHOR BOLTS

CASCO BAY STEEL STRUCTURES, INC.
1 WALLACE AVE. PHONE (207) 780-6722
SOUTH PORTLAND, ME 04106 FAX. (207) 780-6726
TEMBOR STEEL

STRUCTURE: VT 100 OVER WARDSBORO BROOK BRIDGE NO 78 WINDHAM COUNTY		DRAWN: EEO	DATE: 02/27
		CHKD: DBH	DATE: 02/27
LOCATION: TOWN OF JAMAICA, VT		JOB NO.	DWG NO.
PROJ NO. ER-BRF 013-1(16)		529-1	14
CUSTOMER: T. BUCK CONSTRUCTION			REV. 0