


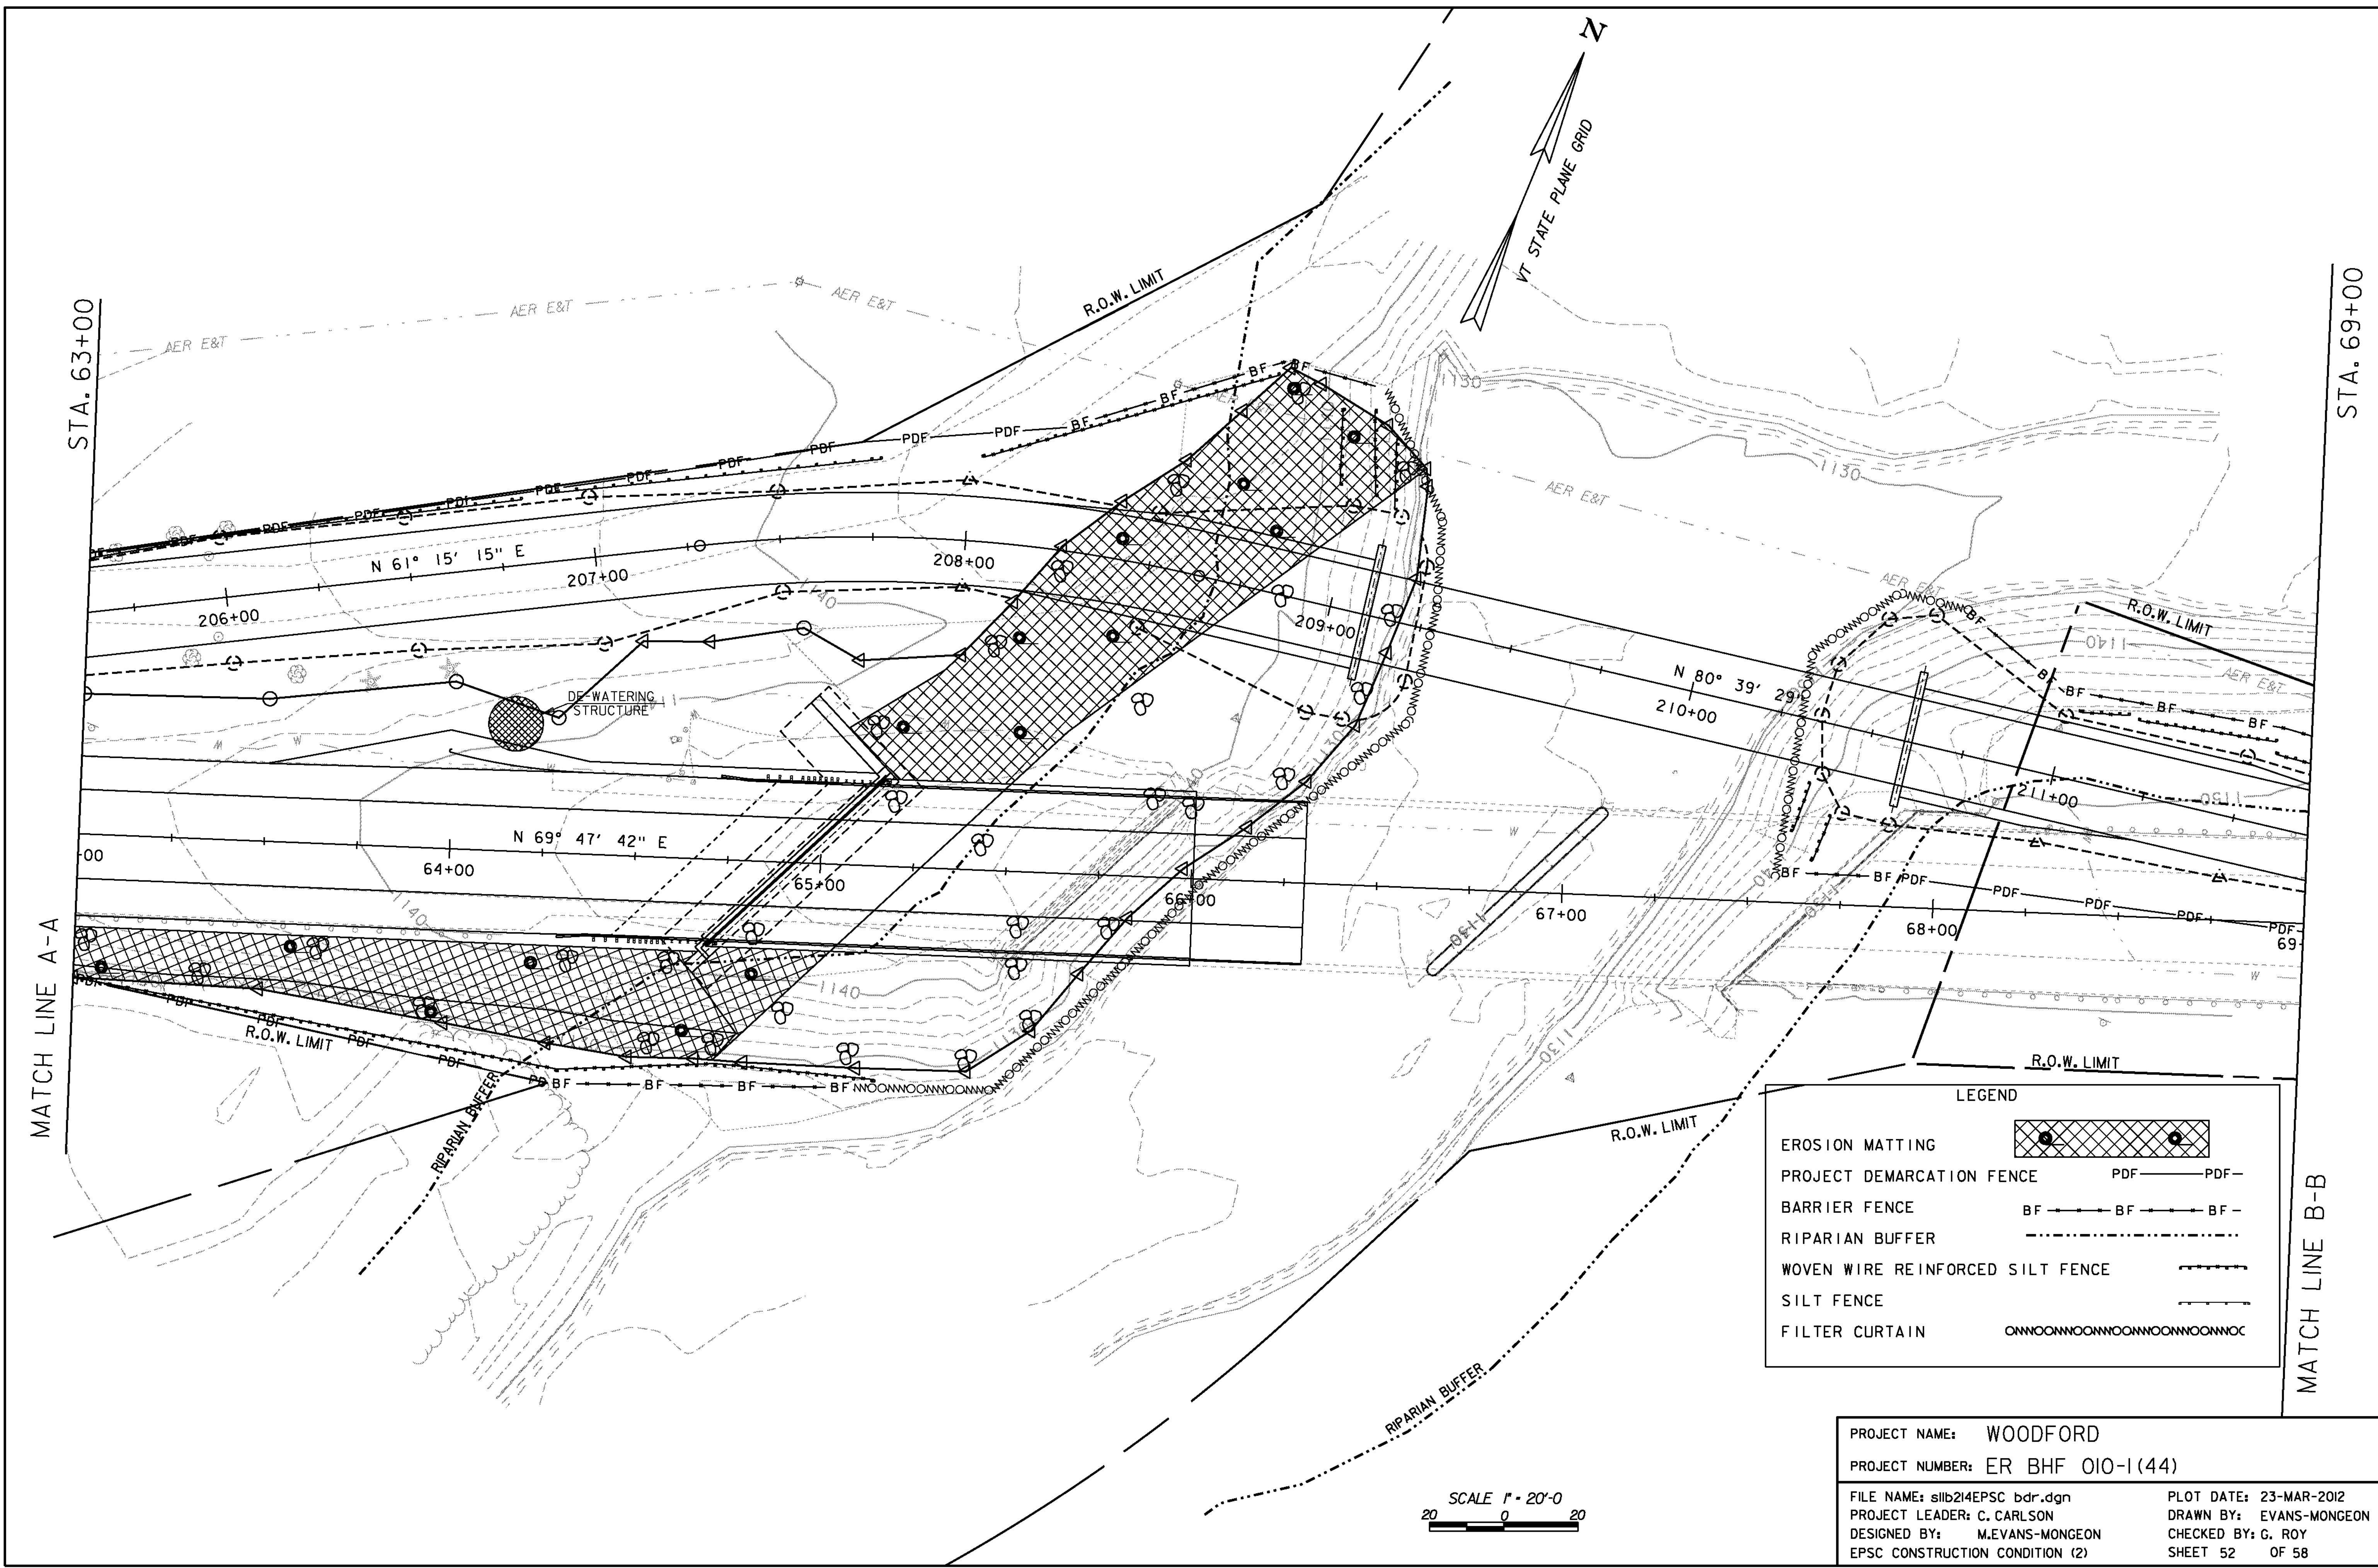

STA. 63+00


STA. 69+00

MATCH LINE A-A

MATCH LINE B-B

LEGEND

EROSION MATTING	
PROJECT DEMARCATION FENCE	PDF — PDF —
BARRIER FENCE	BF — BF — BF —
RIPARIAN BUFFER	— · — · — · — · —
WOVEN WIRE REINFORCED SILT FENCE	— · — · — · — · —
SILT FENCE	— · — · — · — · —
FILTER CURTAIN	ONNOONNOONNOONNOONNOONNO

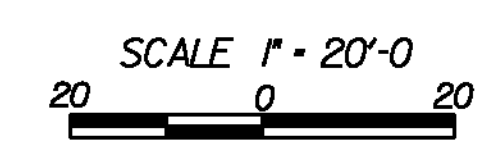

PROJECT NAME: WOODFORD	
PROJECT NUMBER: ER BHF 010-1(44)	
FILE NAME: s11b214EPSC bdr.dgn	PLOT DATE: 23-MAR-2012
PROJECT LEADER: C. CARLSON	DRAWN BY: EVANS-MONGEON
DESIGNED BY: M.EVANS-MONGEON	CHECKED BY: G. ROY
EPSC CONSTRUCTION CONDITION (2)	SHEET 52 OF 58