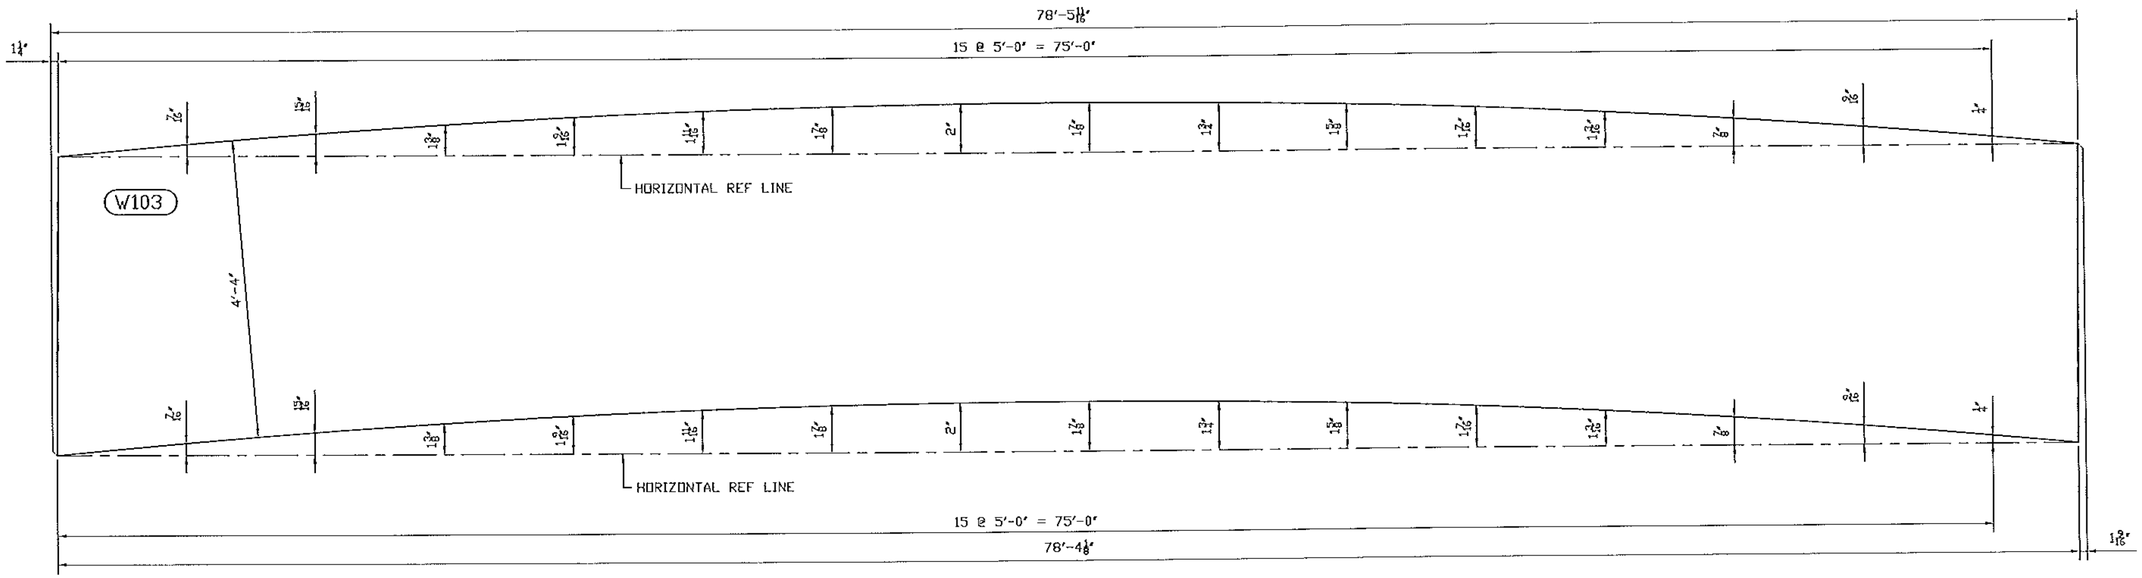

ONE WEB PLATE W103

W103 = PL 1/2"

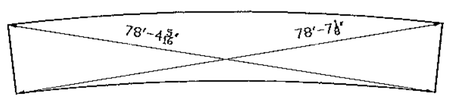

GENERAL NOTES: SEE GN100

No	REVISION	DATE	PAR	VER.
A	FOR APPROVAL	07/06/12	BR	EG

NOTE: BOLT 1 WASHER: 1 WASHER UNDER NUT U.N.
BOLT 2 WASHER: 1 WASHER UNDER HEAD U.N.
1 WASHER UNDER HEAD U.N.

STRUCTAL Bridges
385 River Road, Claremont, NH 03743
Tel(603) 542-5202 Fax(603) 542-5312
a division of CANAM BRIDGES Inc.

PROJECT: VT RT 9, BRIDGE NO. 11
TOWN OF WOODFORD, VT
OVER WALOOMSAC RIVER

TITLE: GIRDER 103G1

REFERENCE: PROJECT NO. ER BHF 010-1 (44)

DRAWN BY BR	DATE JULY 2012	CONTRACT NO UN04260
DESIGNED BY GG	DATE JULY 2012	DRAWING NO 103-1 A

Vermont Agency of Transportation
RECEIVED
CK'D BY M.E.M OK'D BY C.W.M.
July 09, 2012
RESUBMIT APPROVED ✓
BY C. CARLSON DATE 07-27-2012