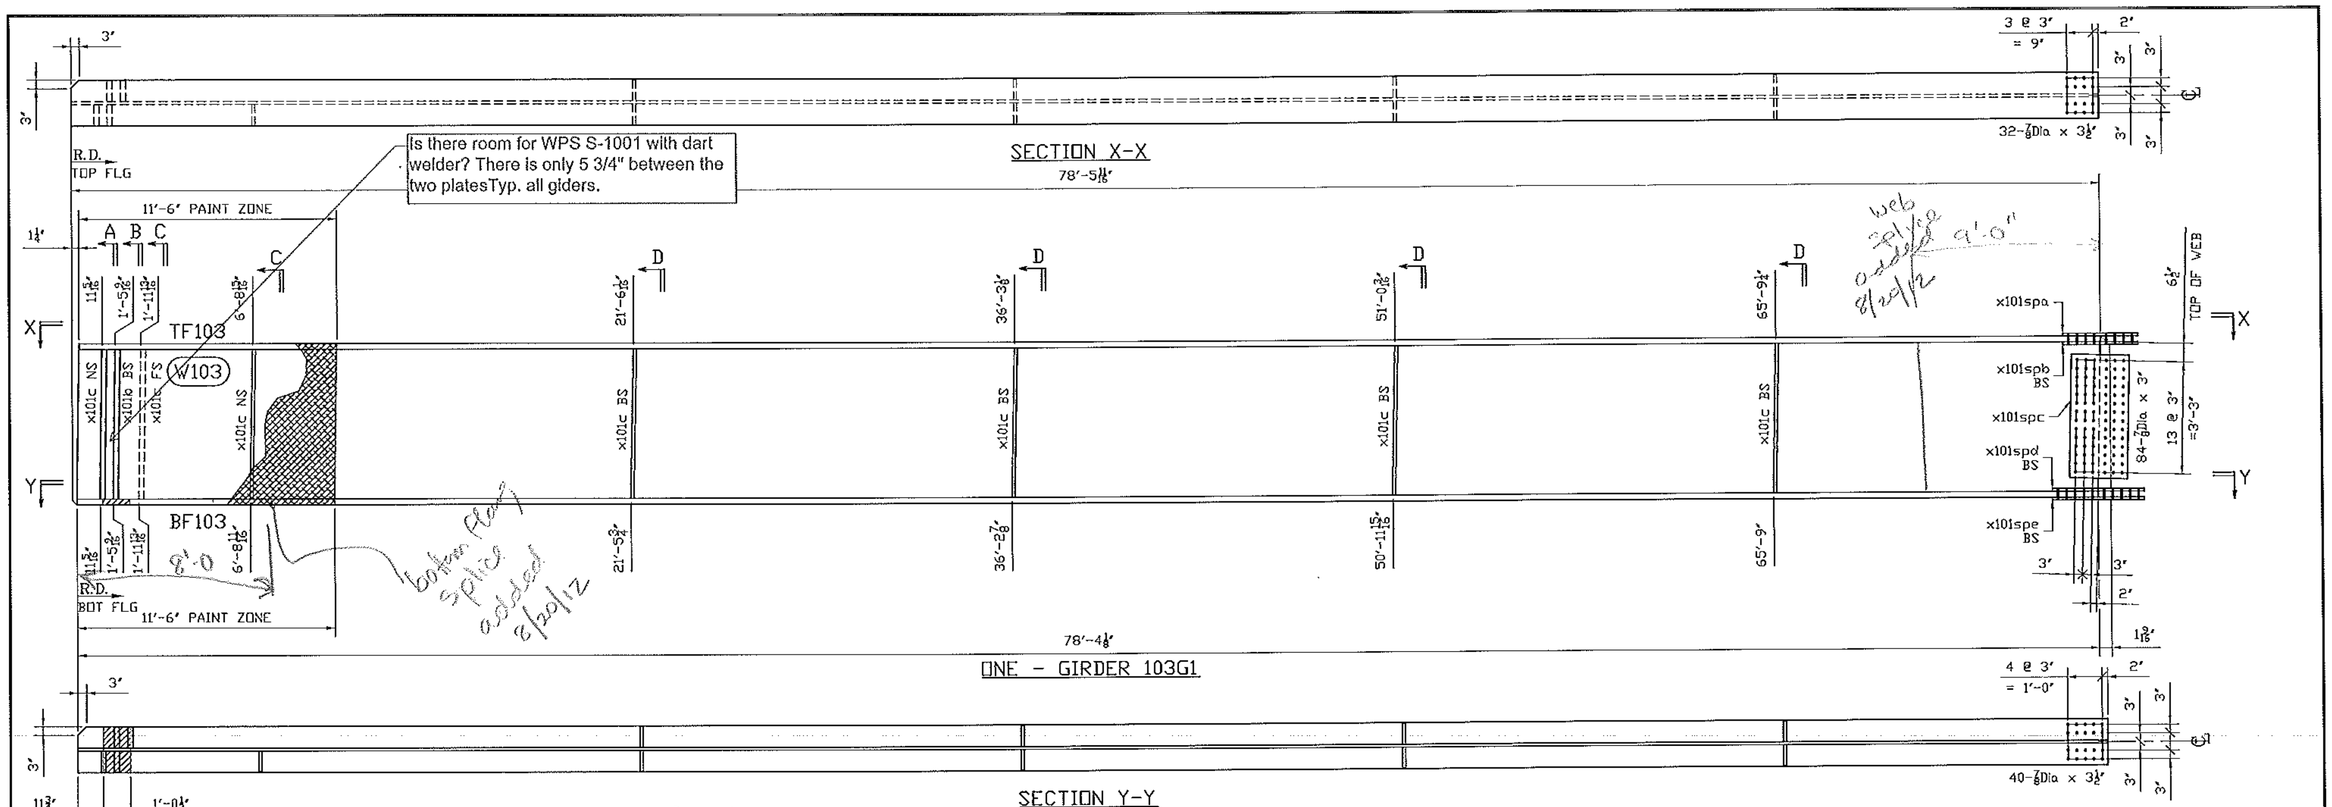

GENERAL NOTES: SEE GN100

HOLES: 15/16 (U.N.)

CLEANING AND PAINTING: SEE SHEET P100 AND P101

See standard specification 506.24(a)(9), no payment will be made for bolts, nuts, washers, they are considered to be incidental

BILL OF MATERIAL

Mark	Qty.	Description	Stl Grd	Length	Remark	ABM	Total Weight	Seq	Qty /Seq
103G1	ONE	GIRDER				16629	16809	1	1
103G1	1	.GIRDER		78-5 11/16					
TF103	1	PL1x16	A709 50W T2	78-4 7/16		100-1	4267		
W103	1	PL1/2x52	A709 50W T2	78-5 11/16		100-2	6943		
BF103	1	PL1x16	A709 50W T2	78-4 3/16		100-1	4266		
x101b	2	PL7/8x7 1/2	A709 50W T2	4-4	VB	101-1	194		
x101c	12	PL1/2x7 1/2	A709 50W T2	4-4		101-2/3	664		
x101spa	1	PL1/2x16	A709 50W T2	2-2 1/4		102-1	60		
x101spb	2	PL1/2x7	A709 50W T2	2-2 1/4		102-2	52		
x101spc	2	PL1/2x43	A709 50W T2	8 1/4		102-3	101		
x101spd	2	PL1/2x7	A709 50W T2	2-8 1/4		102-4	64		
x101spe	1	PL1/2x16	A709 50W T2	2-8 1/4		102-5	73		
FB		FIELD_BOLTS							
78F3	84	.7/8 Dia A325 TYP3		3	1FL WASH		~~67~~		
78F312	72	.7/8 Dia A325 TYP3		3 1/2	1FL WASH		~~58~~		

11

609

Vermont Agency of Transportation
RECEIVED
CK'D BY M.E.M OK'D BY C.W.M.
July 09, 2012
RESUBMIT APPROVED AS NOTED
BY C. CARLSON DATE 07-27-2012

No	REVISION	DATE	PAR	VER.
A	FOR APPROVAL	07/06/12	BR	EG

NOTE: BOLT 1 WASHER: 1 WASHER UNDER NUT U.N.
BOLT 2 WASHER: 1 WASHER UNDER HEAD U.N.
1 WASHER UNDER HEAD U.N.

STRUCTAL Bridges
386 River Road, Claremont, NH 03743
Tel(603) 542-5202 Fax(603) 542-5312
a division of CANAM

PROJECT: VT RT 9, BRIDGE NO. 11
TOWN OF WOODFORD, VT
OVER WALOOMSAC RIVER

TITLE: GIRDER 103G1

REFERENCE: PROJECT NO. ER BHF 010-1 (44)

DRAWN BY	DATE	CONTRACT NO	
BR	JULY 2012	UN04260	
DESIGNED BY	DATE	DRAWING NO	
GG	JULY 2012	103-2 A	

BF 103 8'
BF 102 8'
web 9'