SECTION D–D

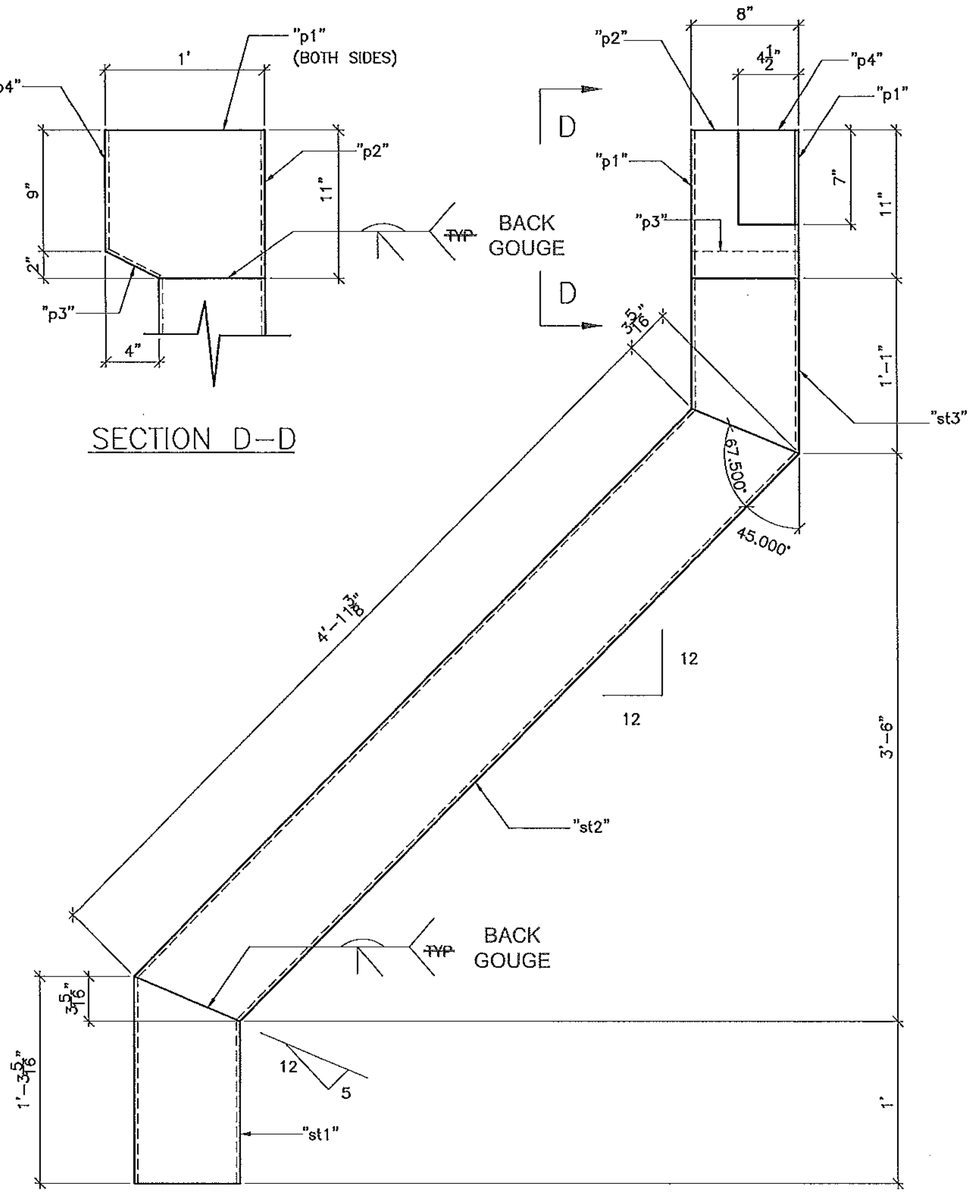

ONE REQ'D, DOWNSPOUT "DS1^{R}", AS SHOWN

ONE REQ'D, DOWNSPOUT "DS1^{L}", OPP. HAND

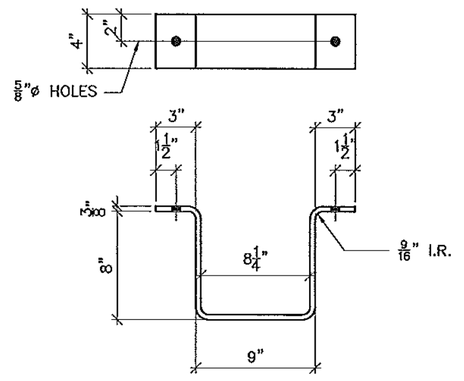

4 REQ'D, $\frac{3}{8}$" BRACKET MARK "BR1"

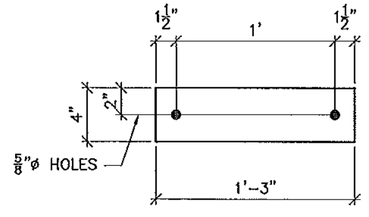

2 REQ'D, $\frac{3}{8}$" BRACKET BAR MARK "B1"

BILL OF MATERIAL

SHIP	SHIP MARK	NO. PCS.	PIECE MARK	DESCRIPTION	LENGTH	REMARKS	WT.
2	DS1R/L			DOWNSPOUT			
		2	st1	TS 8X6X¼	1'–3⅝	ASTM A500	59
		2	st2	TS 8X6X¼	5'–2⅛	ASTM A500	257
		2	st3	TS 8X6X¼	1'–1	ASTM A500	49
		4	p1	PL ¼X11	1'–0		36
		2	p2	PL ¼X7½	0'–11		8
		2	p3	PL ¼X7½	0'–4⅝		5
		2	p4	PL ¼X7½	0'–8⅝		9
4	BR1			PL ⅜X4	2'–8		51
2	B1			PL ⅜X4	1'–3		13
4	AN1			¾"ø ANCHOR BOLT	0'–8	W/N&W	
4	AN2			¾"ø ANCHOR BOLT	1'–0	W/N&W	

Vermont Agency of Transportation

RECEIVED

CK'D BY MEM **OK'D BY** GFR

08/21/2012

RESUBMIT **APPROVED** AS NOTED

BY C. CARLSON **DATE** 08/29/2012

FINISH	HOT DIPPED GALVANIZED				
MATERIAL	AASHTO M270 GR. 36/ASTM A500 GR.B				
HOLES	AS NOTED				
ELECTRODES	PER W.P.S.				
WELDS	AS NOTED				
SURFACE PREP	SSPC–SP8	1	8/21/12	PER APPROVAL	JAC
		NO	DATE	DESCRIPTION	BY
		REVISIONS			

ARC ENTERPRISES, INC.

ADVANCED RESOURCES & CONST. ENTERPRISES, INCORPORATED
P.O. BOX 120 KINGFIELD, ME. 04947
PHONE: (207) 265–2648 – FAX: (207) 265–4054

DRAFTER	JAC	DOWNSPOUT DETAILS	PROJECT NO. BR BHF 010-1(41)
DATE	7/28/12	VERMONT AGENCY OF TRANSPORTATION, TOWN OF WOODFORD ABUTMENT #1 VT JOINT	
CHECKED	MTD	G.C. T BUCK CONSTRUCTION, INC.	DWG. NO. 2
JOB	12–324		