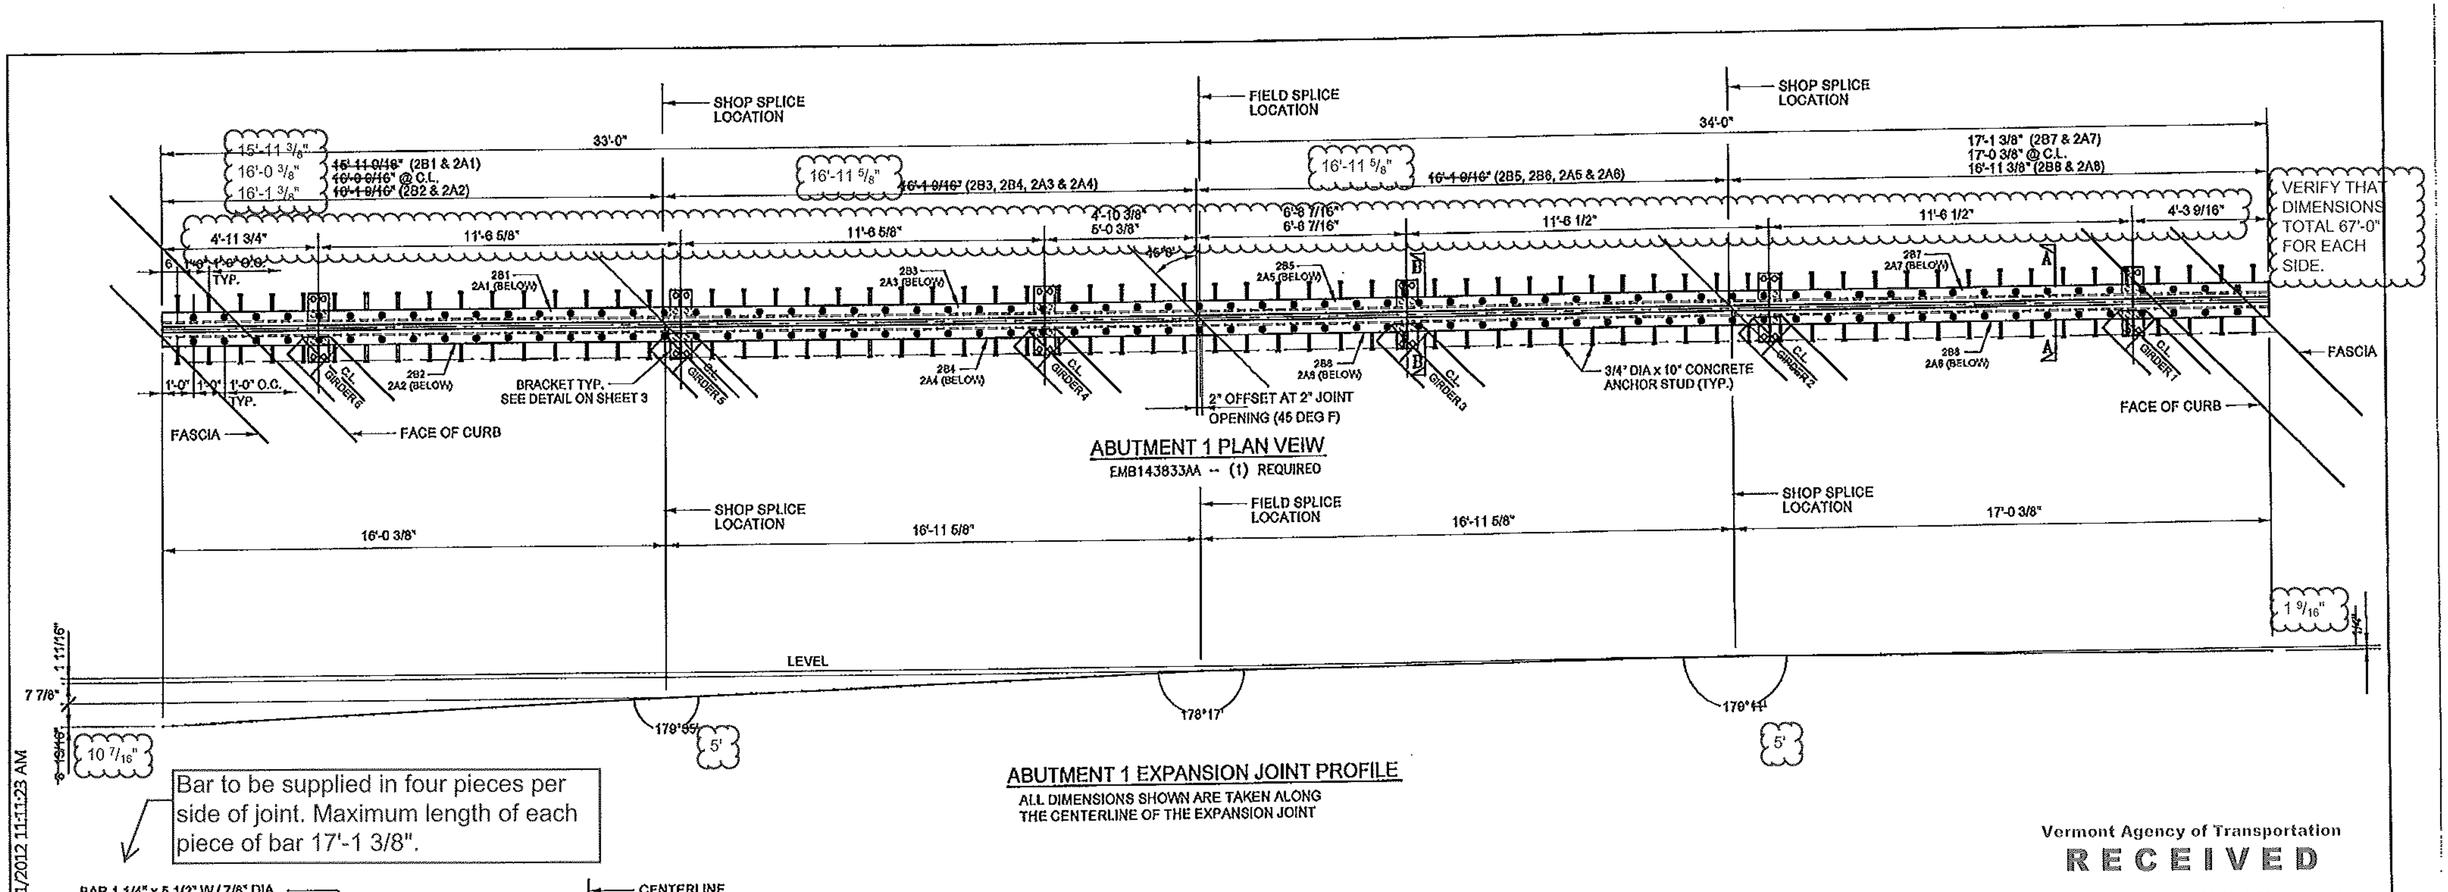

ABUTMENT 1 PLAN VEIW

EMB143833AA -- (1) REQUIRED

ABUTMENT 1 EXPANSION JOINT PROFILE

ALL DIMENSIONS SHOWN ARE TAKEN ALONG THE CENTERLINE OF THE EXPANSION JOINT

Bar to be supplied in four pieces per side of joint. Maximum length of each piece of bar 17'-1 3/8".

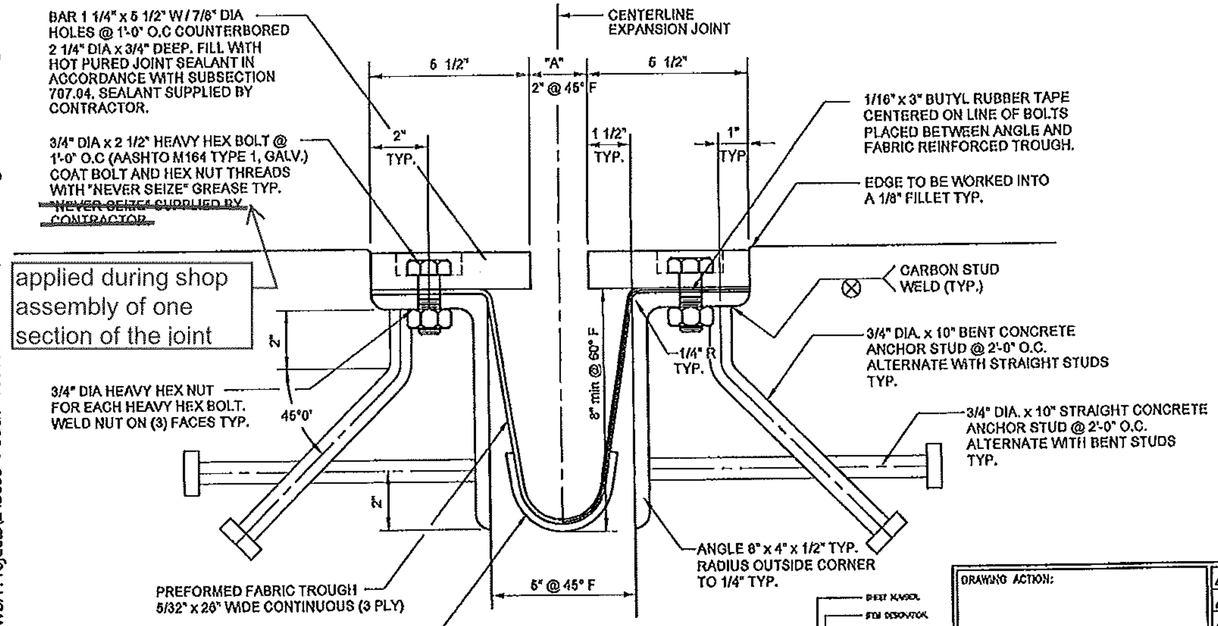

SECTION A-A

MARK SYSTEM

TEMP.	"A" DIST.
0 DEG F	2 3/8"
15 DEG F	2 1/4"
30 DEG F	2 1/8"
45 DEG F	2"
60 DEG F	1 7/8"
75 DEG F	1 3/4"
90 DEG F	1 5/8"
105 DEG F	1 1/2"

Vermont Agency of Transportation
RECEIVED
CK'D BY M.E.M. OK'D BY C.W.M.
08/21/2012
RESUBMIT APPROVED AS NOTED
BY C. CARLSON DATE 09/07/2012

~~Vermont Agency of Transportation~~
~~RECEIVED~~
~~CK'D BY M.E.M. OK'D BY C.W.M.~~
~~Aug. 21, 2012~~
~~RESUBMIT APPROVED AS NOTED~~
~~BY C. CARLSON DATE 09-05-2012~~

STATE: VERMONT
COUNTY: BENNINGTON
PROJECT NO.: ER BHF 010-1(44)
REFERENCE NO.: XXXXXXXXX
DISTRICT: XXX ROUTE: XXX
WBA PRODUCT NO.: EMB143833AA

DRAWING ACTION:

NO.	DESCRIPTION	BY	DATE
3			
2			
1			

Information provided herein, including but not limited to, any drawing, design, photograph, graphic, or statement(s) ("Materials") are proprietary and the property of Watson Bowman Acme Corporation ("Company"). Reproduction, translation, or reduction to any electronic medium or machine readable form, in whole or part, is strictly prohibited, except for the express purpose for which it has been furnished, without prior written consent of Company. All Materials contained herein are provided by Company for information purposes only. Company reserves the right to amend or withdraw any information contained in the Materials without notice. All technical or other advice by Company, whether verbal or written, concerning products, or the use of products in specific situations ("Advice") is given by Company and is used at the Users own risk.

Watson Bowman Acme
WATSON BOWMAN ACME CORPORATION
55 PRIDEN DRIVE AMHERST, N.Y. 14228 TEL: (716) 691-2666 FAX: (716) 691-9229
BASF The Chemical Company

PROJECT: WOODFORD
VT RT 9 BRIDGE NO. 11 OVER ROARING BRANCH OF THE WALLOOMSAC RIVER
WABO PLATE JOINT W/NEOPRENE TROUGH DETAILS

DETAILED BY: JFW	DATE: 8-14-12
CHECKED BY: KF	DATE: 8-14-12
SCALE: NTS	WBA JOB NO.: 143833
SHEET NO.: 2 OF 5	DRAWING NO.: B-30085

G:\Engineer\WBA Projects\143833-T Buck-Woodford ER BHF\030-Drawings\B3008502.dwg, 8/21/2012 11:11:23 AM