RECORD PLANS

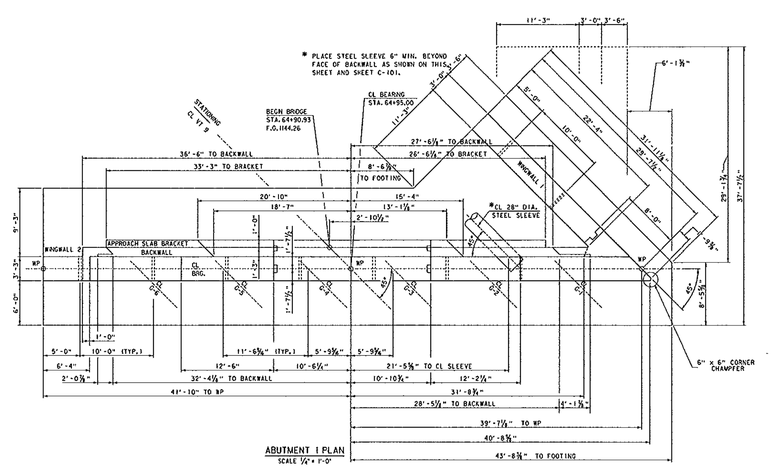

ABUTMENT 1 PLAN
SCALE ¼" = 1'-0"

PROJECT NAME:	
PROJECT NUMBER:	
FILE NAME:	PLOT DATE: 13-SEP-2002
PROJECT LEADER:	DRAWN BY:
DESIGNED BY:	CHECKED BY:
	SHEET 31 OF 58