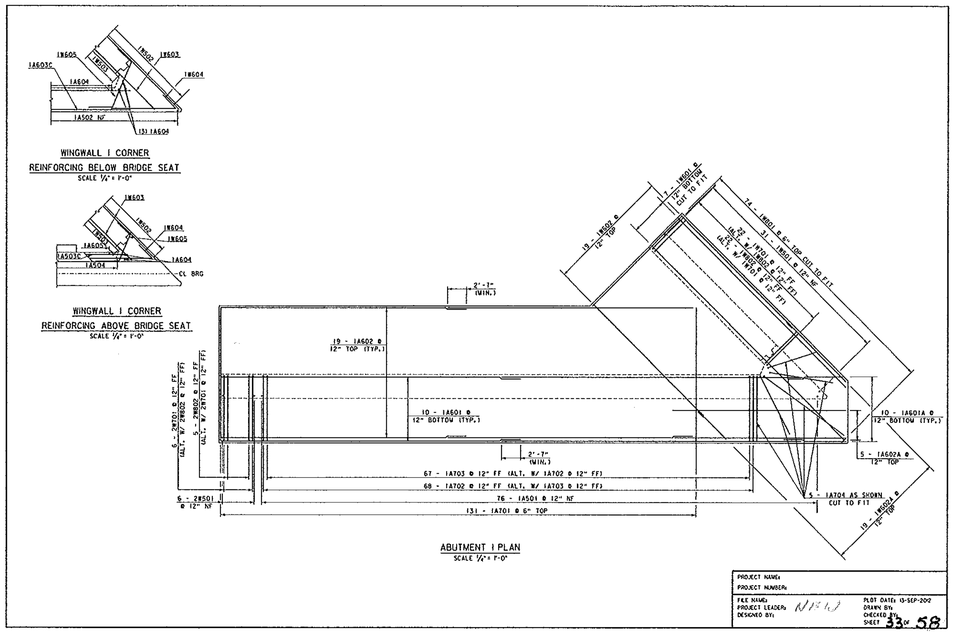RECORD PLANS