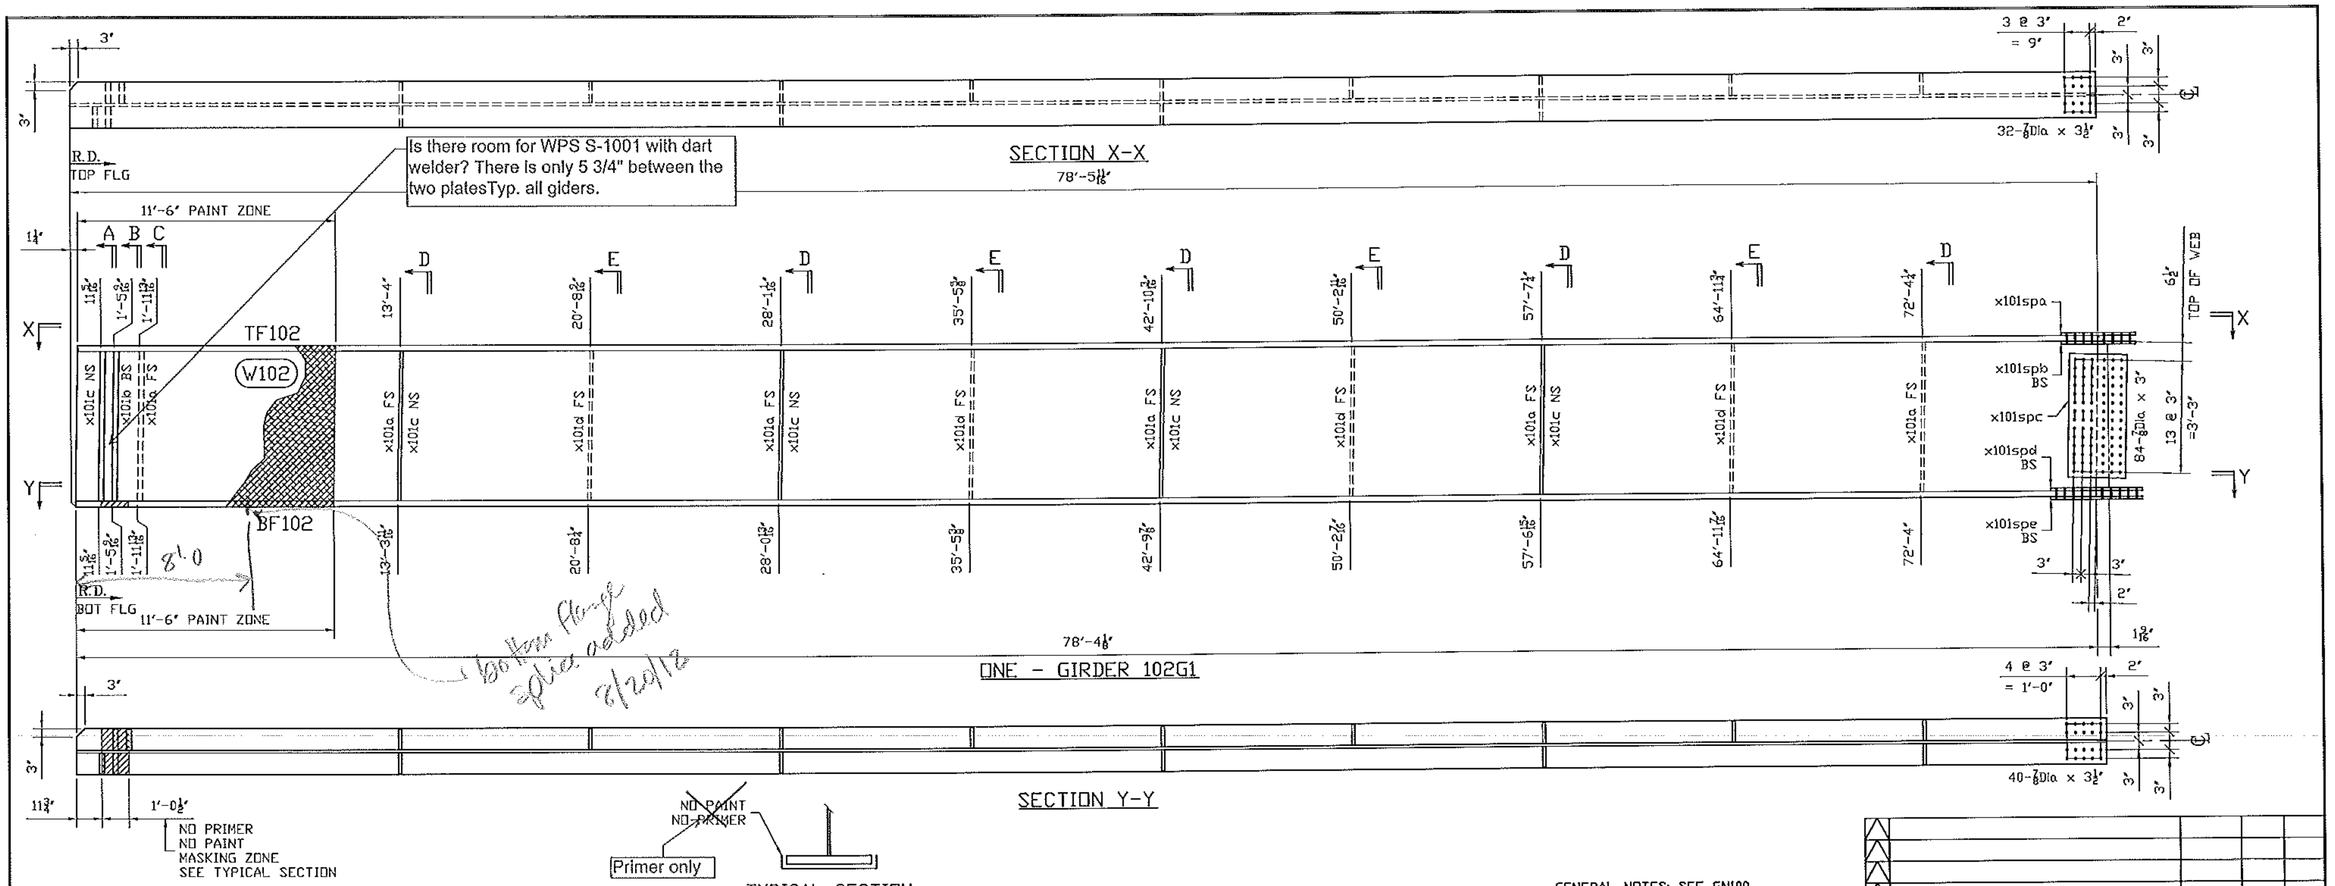

GENERAL NOTES: SEE GN100

HOLES: 15/16 (U.N.)

CLEANING AND PAINTING: SEE SHEET P100 AND P101

No	REVISION	DATE	PAR	VER.
A	FOR APPROVAL	07/06/12	BR	EG

BILL OF MATERIAL

Mark	Qty.	Description	Stl Grd	Length	Remark	ABM	Total Weight	Seq	Qty /Seq
102G1	ONE	GIRDER				16848	16973 K		1
102G1	1	.GIRDER		78-5 11/16					
TF102	1	PL1x16	A70950WT2	78-4 7/16		100-1	4267		
W102	1	PL1/2x52	A70950WT2	78-5 11/16		100-2	6943		
BF102	1	PL1x16	A70950WT2	78-4 1/8		100-1	4265		
x101a	6	PL1/2x7 1/2	A70950WT2	4-4		101-2	332		
x101b	2	PL7/8x7 1/2	A70950WT2	4-4	WB	101-1	194		
x101c	5	PL1/2x7 1/2	A70950WT2	4-4		101-2/3	276		
x101d	4	PL1/2x7 1/2	A70950WT2	4-4		101-3	221		
x101spa	1	PL1/2x16	A70950WT2	2-2 1/4		102-1	60		
x101spb	2	PL1/2x7	A70950WT2	2-2 1/4		102-2	52		
x101spc	2	PL1/2x43	A70950WT2	8 1/4		102-3	101		
x101spd	2	PL1/2x7	A70950WT2	2-8 1/4		102-4	64		
x101spe	1	PL1/2x16	A70950WT2	2-8 1/4		102-5	73		
FB		FIELD_BOLTS							
78F3	84	.7/8 Dia A325 TYP3		3	1FL WASH		~~67~~		
78F312	72	.7/8 Dia A325 TYP3		3 1/2	1FL WASH		~~58~~		

See standard specification 506.24(a)(9), no payment will be made for bolts, nuts, washers, they are considered to be incidental

NOTE: BOLT 1 WASHER: 1 WASHER UNDER NUT U.N.
BOLT 2 WASHER: 1 WASHER UNDER HEAD U.N.
1 WASHER UNDER HEAD U.N.

Vermont Agency of Transportation
RECEIVED
CK'D BY M.E.M OK'D BY C.W.M.
July 09, 2012
RESUBMIT APPROVED AS NOTED
BY C. CARLSON DATE 07-27-2012

STRUCTAL Bridges
a division of CANAM
386 River Road, Claremont, NH 03743
Tel:(603) 542-5202 Fax:(603) 542-5312

PROJECT: VT RT 9, BRIDGE NO. 11
TOWN OF WOODFORD, VT
OVER WALOOMSAC RIVER

TITLE: GIRDER 102G1

REFERENCE: PROJECT NO. ER BHF 010-1 (44)

DRAWN BY	DATE	CONTRACT NO
BR	JULY 2012	UN04260
CHECKED BY GG	DATE JULY 2012	DRAWING NO 102-2 A