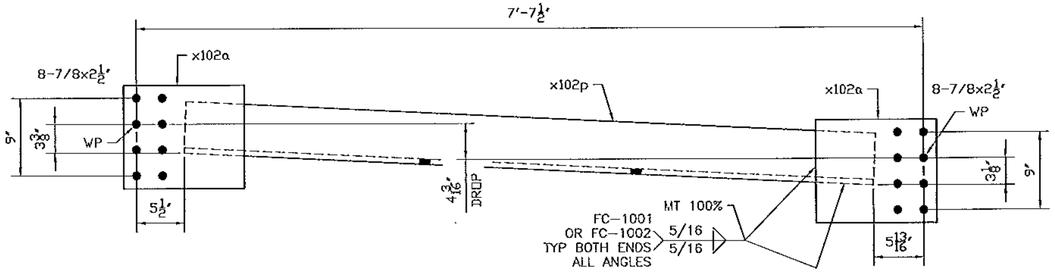

5 - INTERMEDIATE SUPPORT 111CF1

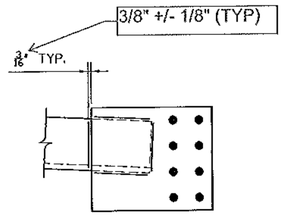

WELD TERMINATION DETAIL

GENERAL NOTES: SEE GN100

HOLES: 15/16 (U.N.)

CLEANING AND PAINTING: SEE SHEET P100 AND P101

No	REVISION	DATE	PAR	VER.
A	FOR APPROVAL	07/06/12	BR	EG

BILL OF MATERIAL

Mark	Qty.	Description	SU Grd	Length	Remark	ABM	Total Weight	Seq	Qty /Seq
111CF1	5	INTERMEDATE SUPPORT				1048	1112	1	5
111CF1	5	INTERMEDATE SUPPORT		7-10 1/2					
x102a	10	PL1/2x12	A709 50W	1-2		107-2	238		
x102p	5	L6x6x5/8	A709 50W	6-8 5/16		107-1	810		
FB		FIELD BOLTS							
78F212	80	7/8 Dia A325 TYP3		2 1/2	1FL WASH				

See standard specification 506.24(a)(9), no payment will be made for bolts, nuts, washers, they are considered to be incidental

Vermont Agency of Transportation

RECEIVED

CK'D BY M.E.M OK'D BY C.W.M.

July 09, 2012

RESUBMIT APPROVED AS NOTED

BY C. CARLSON DATE 07-27-2012

NOTE: BOLT 1 WASHER: 1 WASHER UNDER NUT U.N.
BOLT 2 WASHER: 1 WASHER UNDER HEAD U.N.
1 WASHER UNDER HEAD U.N.

STRUCTAL Bridges
a division of CANAM
386 River Road, Claremont, NH 03743
Tel(603) 542-5202 Fax(603) 542-5312

PROJECT: VT RT 9, BRIDGE NO. 11
TOWN OF WOODFORD, VT
OVER WALOOMSAC RIVER

TITLE: INTERMEDATE SUPPORT AT WATERLINE

REFERENCE: PROJECT NO. ER BHF 010-1 (44)

DRAWN BY	DATE	CONTRACT ID
BR	JULY 2012	UN04260
CHECKED BY	DATE	DRAWING ID
GG	JULY 2012	111 A