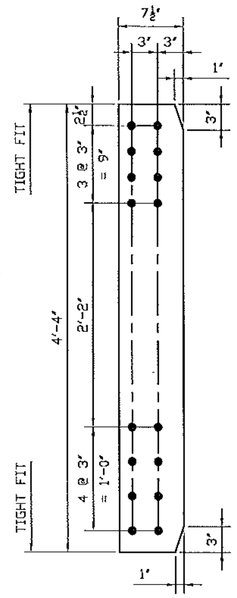

PL1/2x7 1/2x4-4 - x101a

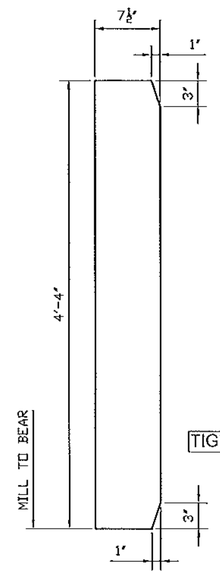

PL7/8x7 1/2x4-4 - x101b

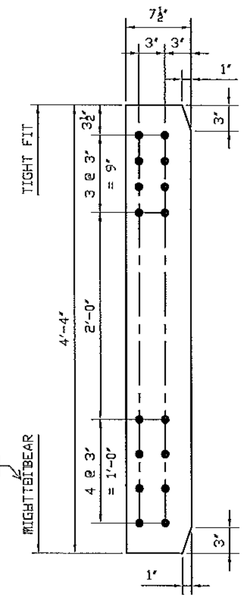

PL1/2x7 1/2x4-4 - x101c

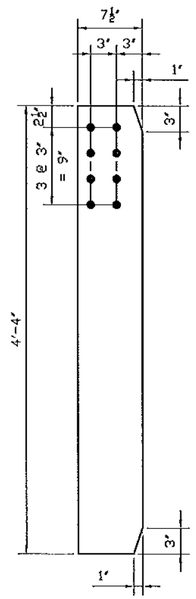

PL1/2x7 1/2x4-4 - x101d

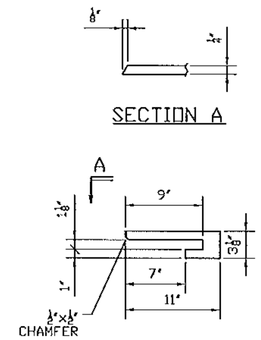

PL1/4x3 1/8x11 - x101e

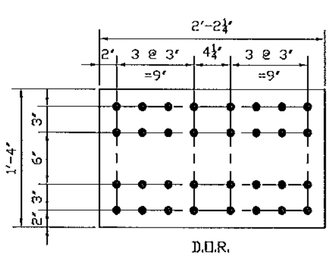

PL1/2x16x2-2 1/4 - x101spa

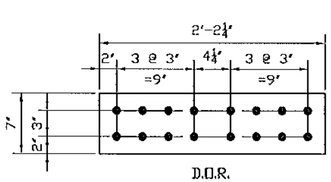

PL1/2x7x2-2 1/4 - x101spb

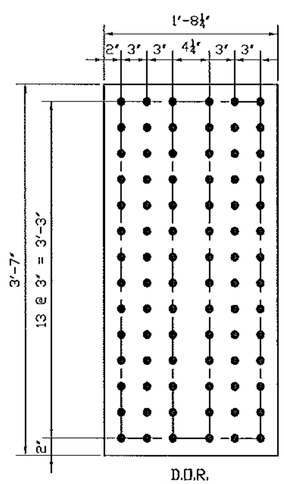

PL1/2x43x1-8 1/4 - x101spc

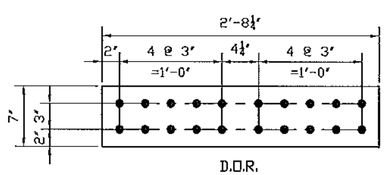

PL1/2x7x2-8 1/4 - x101spd

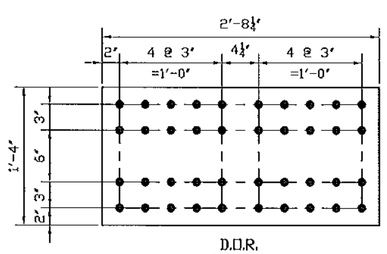

PL1/2x16x2-8 1/4 - x101spe

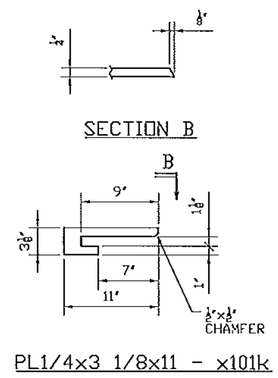

PL1/4x3 1/8x11 - x101k

GENERAL NOTES: SEE GN100

HOLES: 15/16 (U.N.)

CLEANING AND PAINTING: SEE SHEET P100 AND P101

No	REVISION	DATE	PAR	VER.
A	FOR APPROVAL	07/06/12	BR	EG

Vermont Agency of Transportation
RECEIVED
CK'D BY M.E.M OK'D BY C.W.M.
July 09, 2012
RESUBMIT APPROVED AS NOTED
BY C. CARLSON DATE 07-27-2012

NOTE: BOLT 1 WASHER: 1 WASHER UNDER NUT U.N.
BOLT 2 WASHER: 1 WASHER UNDER HEAD U.N.
1 WASHER UNDER HEAD U.N.

STRUCTAL Bridges
386 River Road, Claremont, NH 03743
Tel:(603) 542-5202 Fax:(603) 542-5312
a division of CANAM BUDD Inc.

PROJECT: VT RT 9, BRIDGE NO. 11
TOWN OF WOODFORD, VT
OVER WALOOMSAC RIVER

TITLE: GIRDER DETAILS

REFERENCE: PROJECT NO. ER BHF 010-1 (44)

DRAWN BY	DATE	CONTRACT NO.
BR	JULY 2012	UN04260
CHECKED BY	DATE	DRAWING NO.
GG	JULY 2012	X101 A