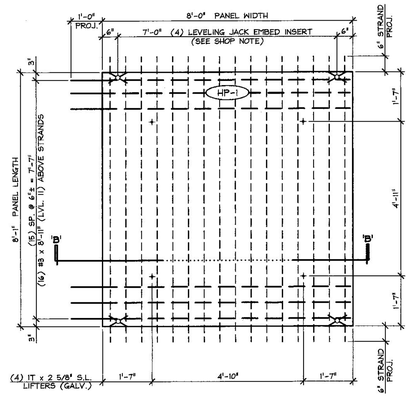

DECK PANEL - 'HP-1'

1/2" = 1'-0"

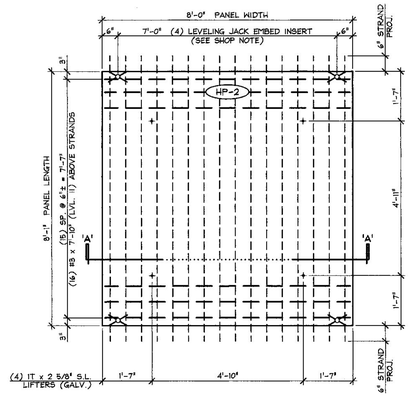

DECK PANEL - 'HP-2'

1/2" = 1'-0"

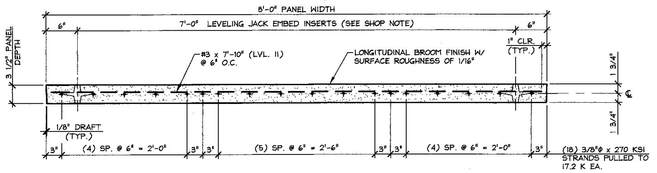

DECK PANEL SECTION - 'A-A'

1" = 1'-0"

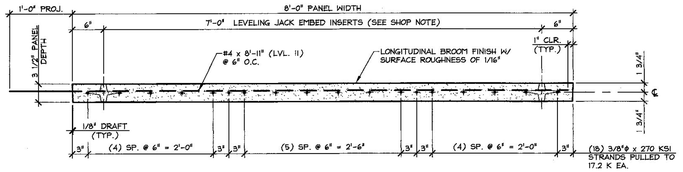

DECK PANEL SECTION - 'B-B'

1" = 1'-0"

① ③ ⑤ ⑦ ⑨ ⑪ ⑬ ⑮ ⑰ ⑱ ⑯ ⑭ ⑫ ⑩ ⑧ ⑥ ④ ②

DETENSIONING SCHEDULE

N.T.S.

SHOP NOTE:
INSTALL LEVELING JACK INSERTS FLUSH TO FORM AT ENDS OF PANELS ON FIRST TWO (2) STRANDS AT EA. SIDE OF PANEL

MARK:	HP-1	QTY.:	8	WT.:	1.4 T	VOL.:	0.69 cy
MARK:	HP-2	QTY.:	52	WT.:	1.4 T	VOL.:	0.69 cy
MARK:	-	QTY.:	-	WT.:	-	VOL.:	-

MATERIAL LIST / PANEL

ITEM	DESCRIPTION	QTY./PANEL HP-1	HP-2	-
1	#3 x 7'-10" (LEVEL II, DUAL COATED)		16	
2	#3 x 8'-11" (LEVEL II, DUAL COATED)	16		
3				
4				
5				
6	IT x 2 5/8" SWIFT LIFT LIFTER (GALV.)	4	4	
7				
8	LEVELING JACK EMBED INSERTS	4	4	
9				
10				
11				

T.Y. LIN INTERNATIONAL

THE STAMPED DOCUMENTS ARE HEREBY:

___ APPROVED
_X_ APPROVED AS NOTED
___ REVISE AND RESUBMIT

SEE TRANSMITTAL FOR ADDITIONAL INFORMATION AS APPLICABLE.

THIS REVIEW IS FOR GENERAL CONFORMANCE WITH DESIGN CONCEPT ONLY. ANY DEVIATION FROM THE PLANS OR SPECIFICATIONS NOT CLEARLY NOTED BY THE CONTRACTOR HAS NOT BEEN REVIEWED. REVIEW BY THE ENGINEER SHALL NOT RELIEVE THE CONTRACTOR OF THE CONTRACTUAL RESPONSIBILITY FOR ANY ERRORS OR DEVIATION FROM THE CONTRACT REQUIREMENTS.

RICK HEBERT (REVIEWER) 5/5/2014 (DATE)

APPROVAL STAMP:

J.P. CARRARA & SONS INC.
Precast & Prestress Manufacturer
2484 OGE STR., MIDDLEBURY, VERMONT 05753 Phone:(802)388-6361 Fax:(802)388-9010

A.L. St. ONGE CONTRACTOR, INC.
CONTRACTOR
MONTGOMERY, VERMONT

STATE OF VERMONT AGENCY OF TRANSPORTATION
COUNTY OF LAMOILLE

DATE: APRIL 10, 2014
SCALE: NOTED

TOWN OF HYDE PARK
VT ROUTE 15 (MINOR ARTERIAL)
BRIDGE NO.: 42 PROJECT NO.: STP CULV(26)

CHKD: - DFTM: B.L.
JOB NO: 23427-014

PRESTRESSED S.I.P. FORM PANEL DETAILS

DWG. NO: P1

F:\VT-Bridges\23427-14 Hyde Park\23427-P1.dwg, 4/11/2014 1:40:10 PM