# STATE OF VERMONT
# AGENCY OF TRANSPORTATION

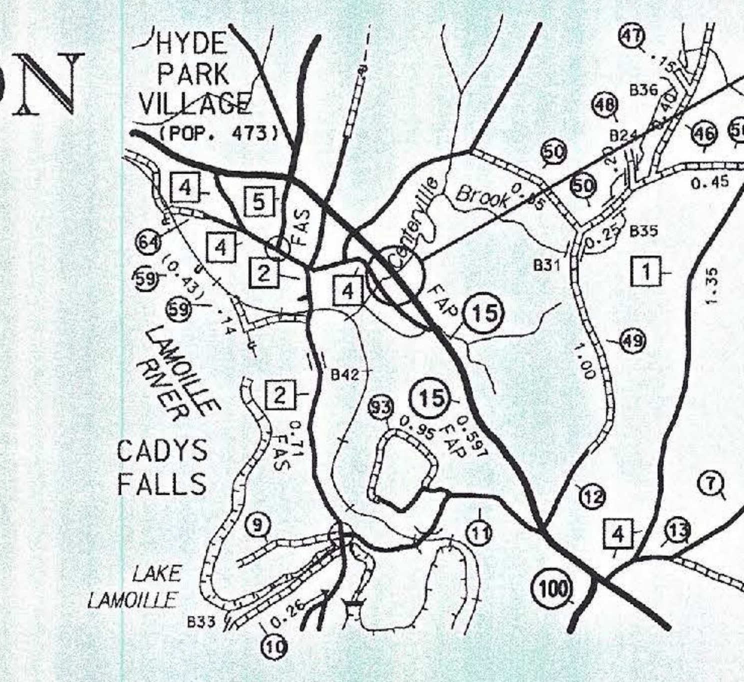


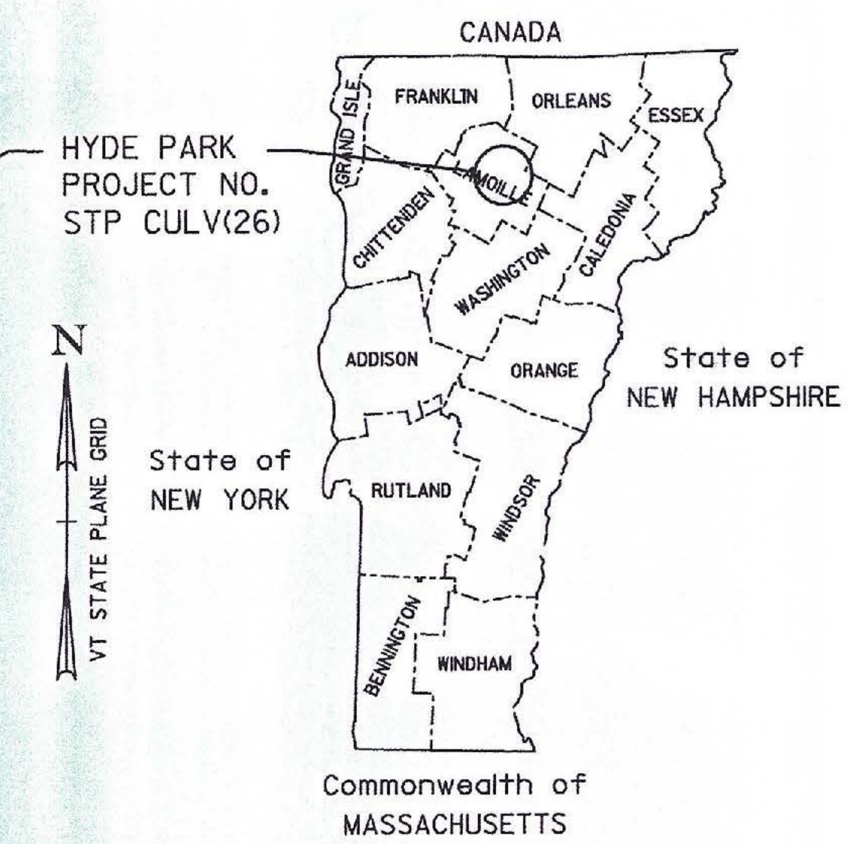


SEE SHEET 2 FOR INDEX OF SHEETS AND STANDARDS LIST.

# PROPOSED IMPROVEMENT
# BRIDGE PROJECT
# TOWN OF HYDE PARK
# COUNTY OF LAMOILLE
# VT. ROUTE 15 (MINOR ARTERIAL) BRIDGE NO. 42

BEGINNING AT A POINT, ON VT ROUTE 15, IN THE TOWN OF HYDE PARK APPROXIMATELY 2959 FEET (0.560 MILES) WESTERLY OF HYDE PARK/MORRISTOWN TOWN LINE AND EXTENDING EASTERLY ALONG VT ROUTE 15 APPROXIMATELY 235 FEET (0.045 MILES).

| | | |
|---|---|---|
| STRUCTURE LENGTH: | 129.04 FEET | = 0.024 MILES |
| ROADWAY LENGTH: | 105.96 FEET | = 0.020 MILES |
| PROJECT LENGTH: | 235.00 FEET | = 0.045 MILES |

WORK TO BE PERFORMED UNDER THIS PROJECT INCLUDES REPLACEMENT OF BRIDGE #42 WITH A NEW BRIDGE ON EXISTING ALIGNMENT WITH CHANNEL WORK AND OTHER RELATED HIGHWAY ITEMS.

## RECORD PLANS

CONTRACTOR: A.L. ST. ONGE CONTRACTOR, INC. – MONTGOMERY, VT

RESIDENT ENGINEER: ROBERT SUCKERT

CONSTRUCTION BEGAN: APRIL 23, 2014

CONSTRUCTION COMPLETE: NOVEMBER 14, 2014

RECORD PLANS BY: ROBERT SUCKERT & KEVIN KING

I HEREBY CERTIFY THAT ALL THE CONSTRUCTION REQUIRED BY THIS SET OF DRAWINGS HAS BEEN ACCOMPLISHED AS INDICATED HEREIN.

BY [signature] RESIDENT ENGINEER

DATE 3-2-17

NOTE: Any further information concerning final quantities, amounts or other details relative to this project may be found at Central Files in the electronic archives.

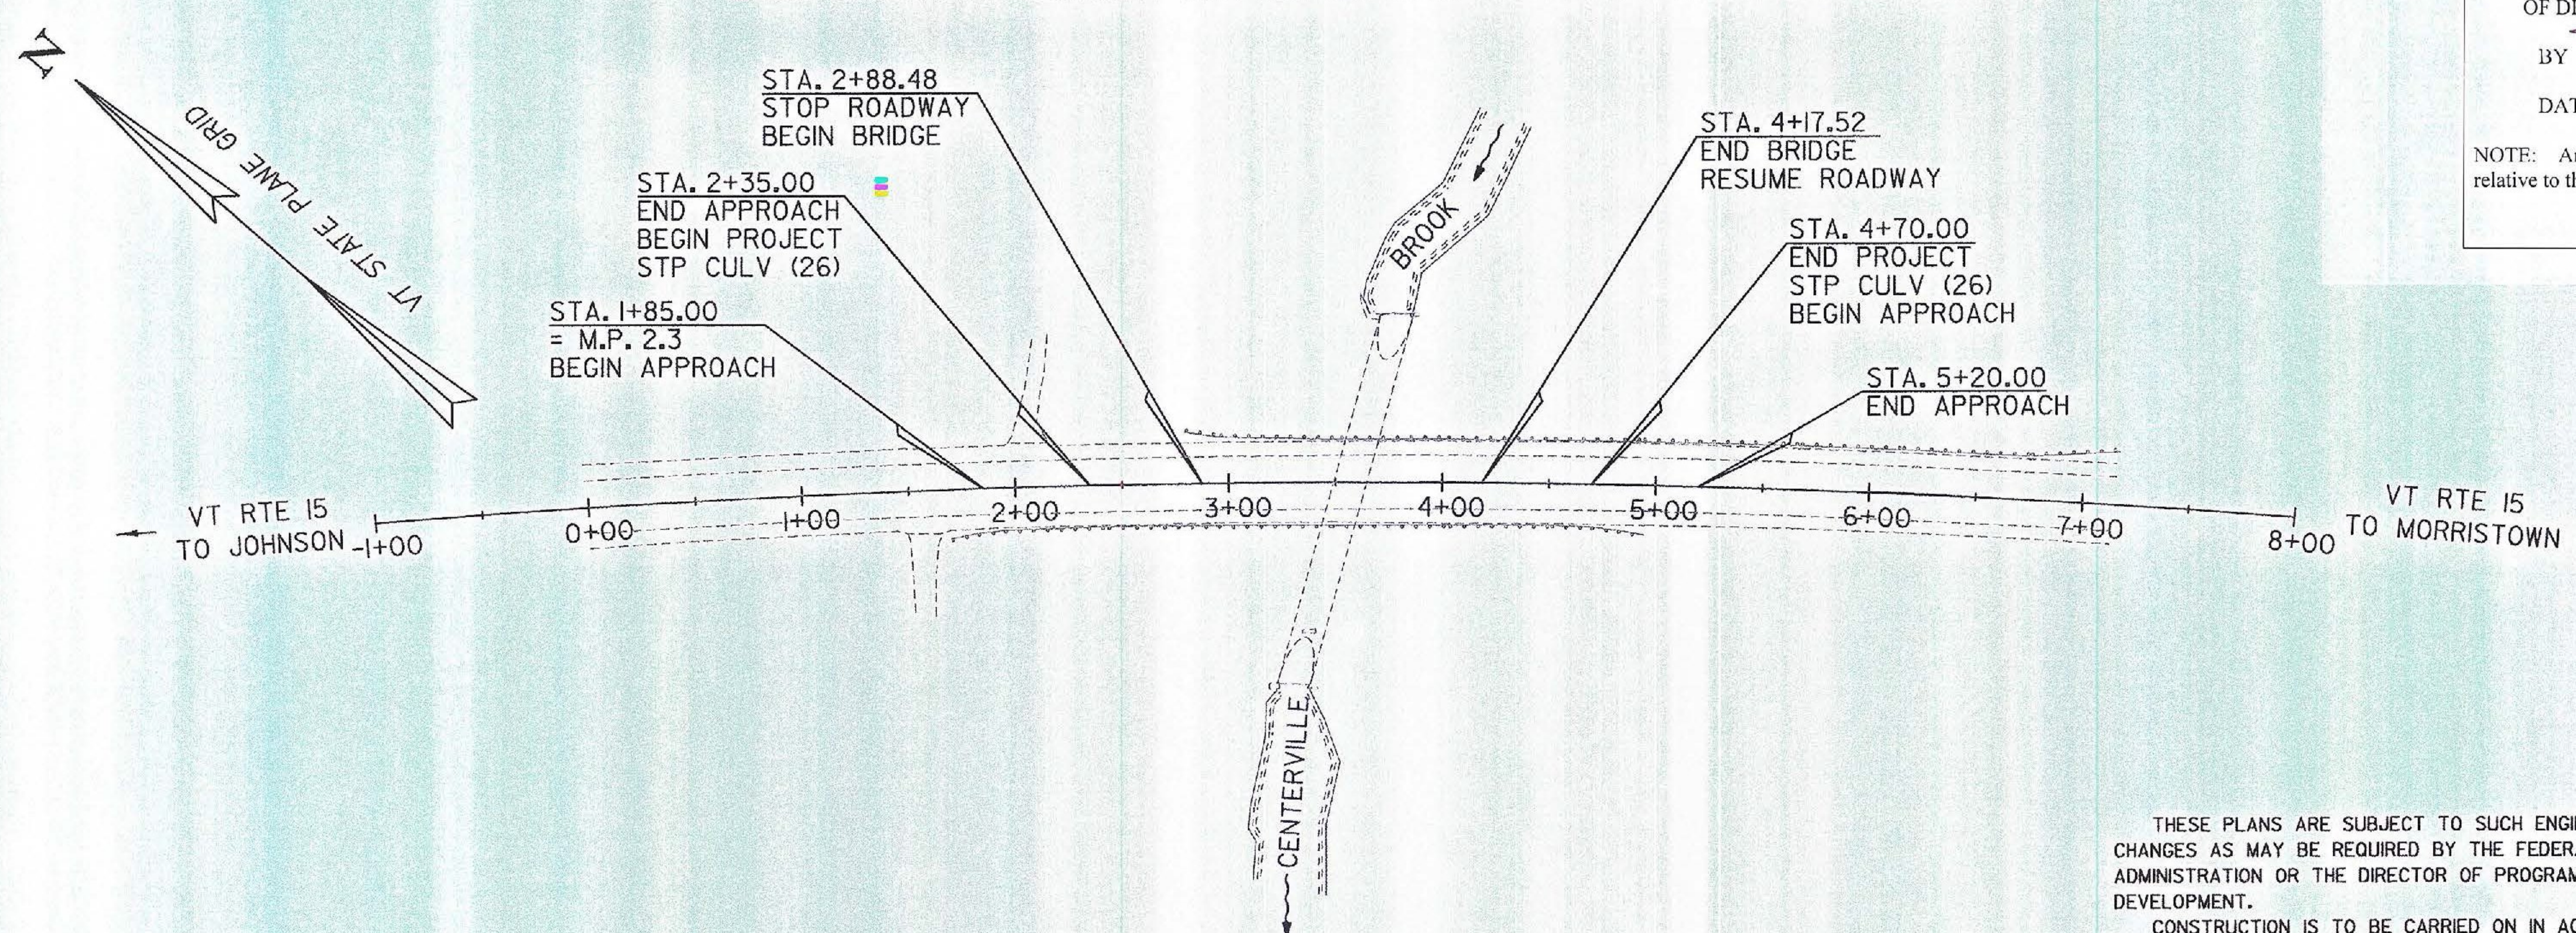


BUILT AS DESIGNED

QUALITY ASSURANCE PROGRAM: LEVEL 2

**CONVENTIONAL SYMBOLS**

- COUNTY LINE
- TOWN LINE
- LIMITS OF ACCESS
- POINT OF ACCESS
- FENCE LINE
- STONE WALL
- TRAVELED WAY
- GUARD RAIL
- RAILROAD
- SURVEY LINE
- CULVERT
- POWER POLE
- TELEPHONE POLE
- TREES
- CONTROL OF ACCESS
- PROPERTY LINE
- R.O.W. TAKING LINE
- SLOPE RIGHTS (SR)
- TOP OF CUT
- TOE OF SLOPE

SURVEYED BY : R. GAUVIN PC & T. YEFCHAK

SURVEYED DATE : 4/23/2012

DATUM
VERTICAL NAVD 88 (GEOID09) FT
HORIZONTAL NAD 83 (CORS) sFT

60 0 60
SCALE IN FEET

THESE PLANS ARE SUBJECT TO SUCH ENGINEERING CHANGES AS MAY BE REQUIRED BY THE FEDERAL HIGHWAY ADMINISTRATION OR THE DIRECTOR OF PROGRAM DEVELOPMENT.

CONSTRUCTION IS TO BE CARRIED ON IN ACCORDANCE WITH THESE PLANS AND THE STANDARD SPECIFICATIONS FOR CONSTRUCTION DATED 2011, AS APPROVED BY THE FEDERAL HIGHWAY ADMINISTRATION ON JULY 20, 2011 FOR USE ON THIS PROJECT, INCLUDING ALL SUBSEQUENT REVISIONS AND SUCH REVISED SPECIFICATIONS AND SPECIAL PROVISIONS AS ARE INCORPORATED IN THESE PLANS.

T·Y·LIN INTERNATIONAL

STATE OF VERMONT RICHARD M. HEBERT No. 7716 Structural LICENSED PROFESSIONAL ENGINEER

DIRECTOR OF PROGRAM DEVELOPMENT
APPROVED [signature] DATE 11-12-13

PROJECT MANAGER : DANNY LANDRY, P.E.

PROJECT NAME : HYDE PARK
PROJECT NUMBER : STP CULV (26)

SHEET 1 OF 60 SHEETS