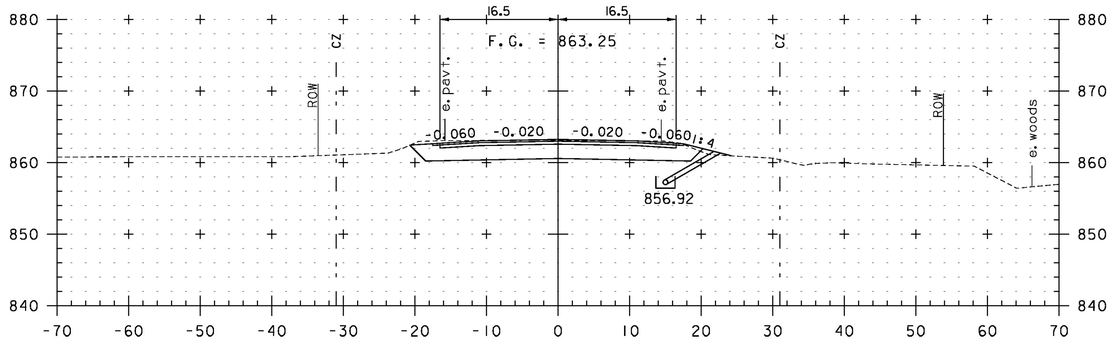

425+00

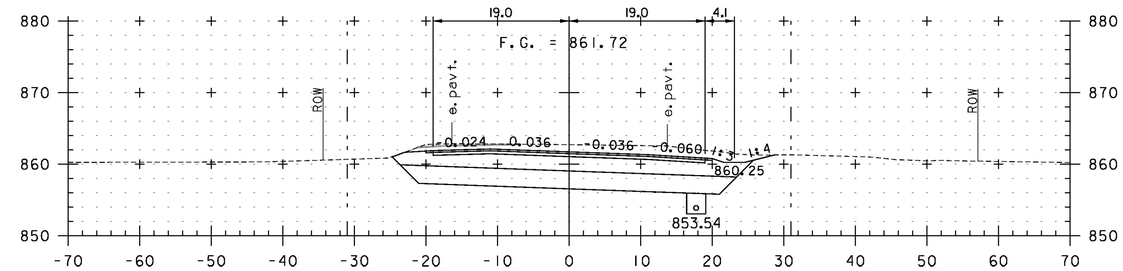

426+50

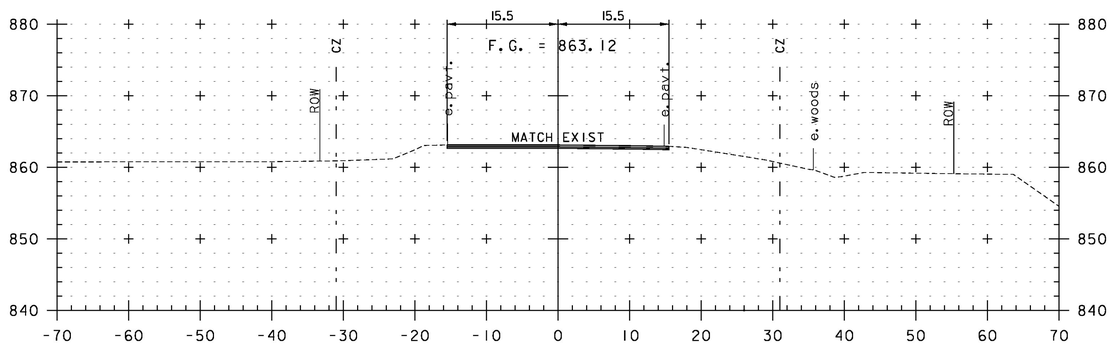

424+50
BEGIN PROJECT

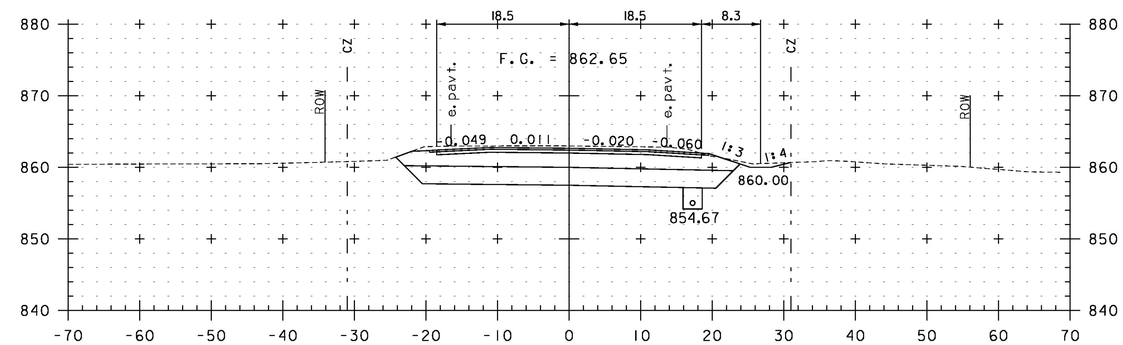

426+00

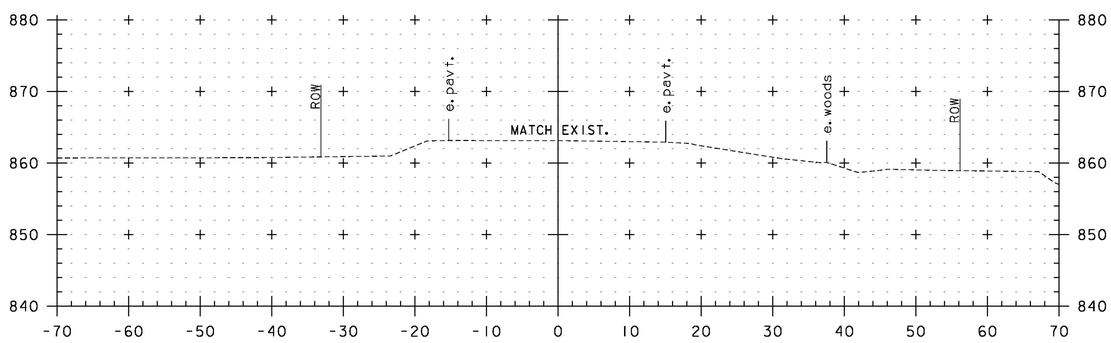

424+25
BEGIN APPROACH

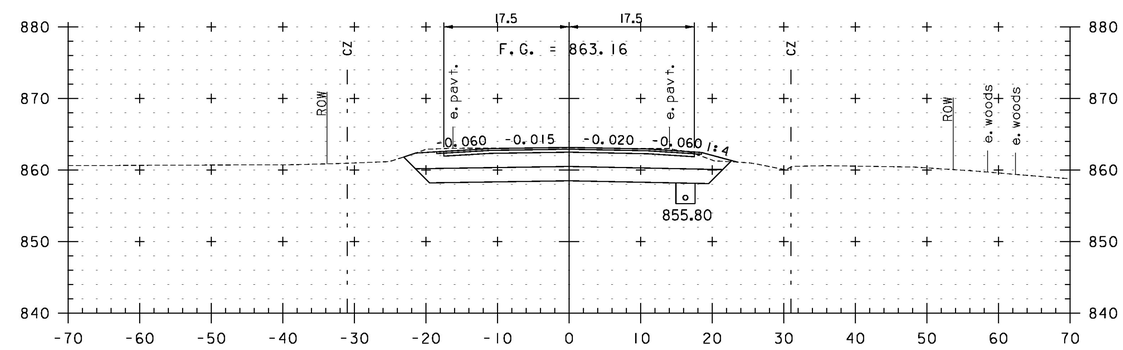

425+50

STA. 424+25 TO STA. 426+50

0 10 20
(SCALE 1" = 10')

CONSULTING ENGINEERS

PROJECT NAME: LUNENBURG	
PROJECT NUMBER: NH CULV(27)	
FILE NAME: IIB294/cos/zIIb294xsl.dgn	PLOT DATE: 8/6/2015
PROJECT LEADER: J. BYATT	DRAWN BY: M. HALEY
DESIGNED BY: M. HALEY	CHECKED BY: P. SHEDD
ROADWAY CROSS SECTIONS I	SHEET 50 OF 74

CLD 12-0106 MODEL: XS01