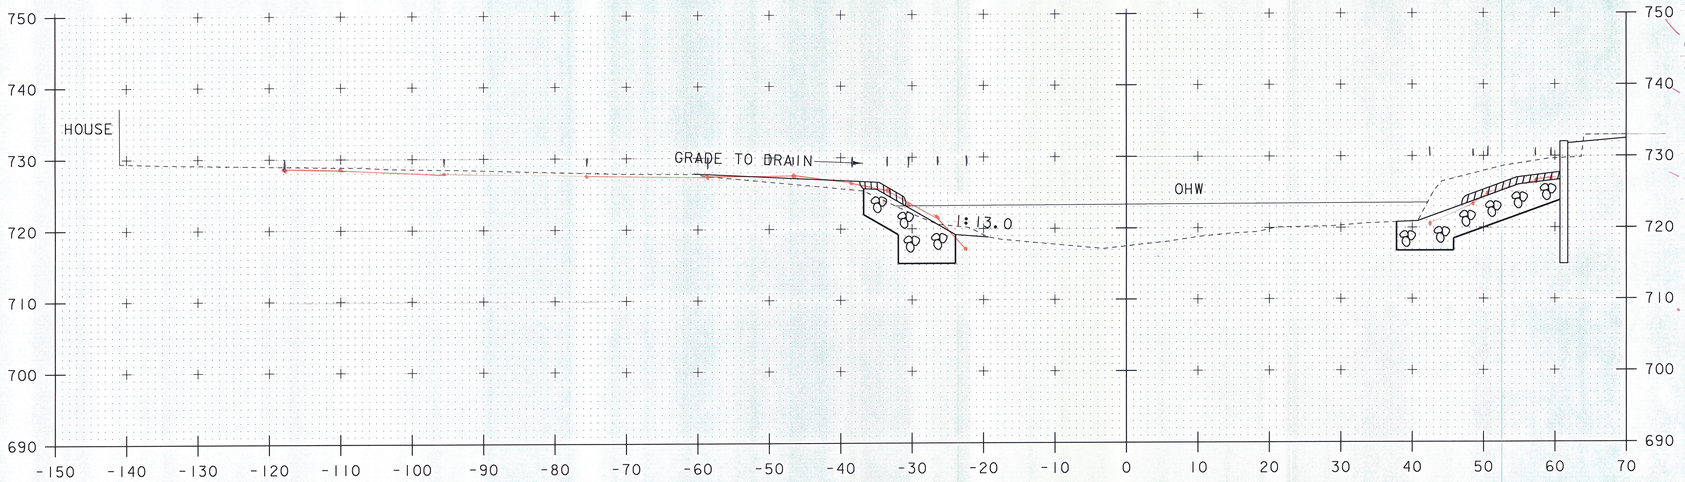

11+20

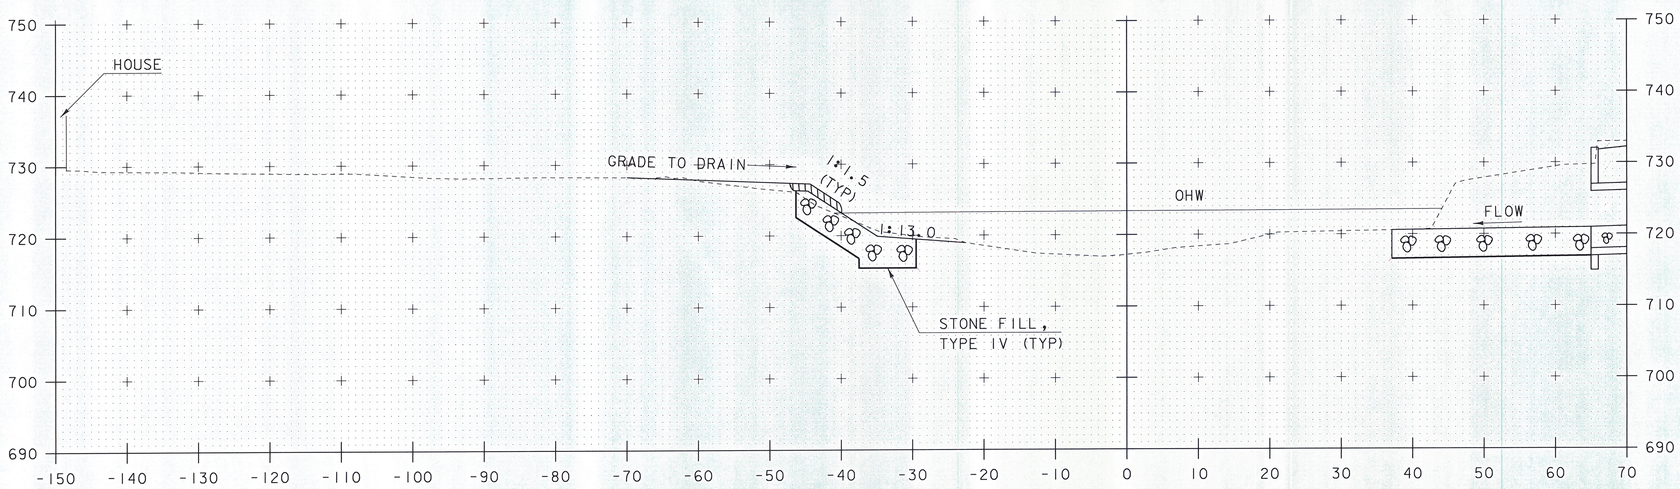

11+10

SCALE 1" = 10'-0"
10 0 10

STA. 11+10 TO STA. 11+20

PROJECT NAME: JAMAICA	
PROJECT NUMBER: ER-BRF 015-1(23)	
FILE NAME: sllb316.xs.dgn	PLOT DATE: 07-DEC-2012
PROJECT LEADER: K. HIGGINS	DRAWN BY: K. FRIEDLAND
DESIGNED BY: G. LAROCHE	CHECKED BY: G. LAROCHE
CHANNEL SECTIONS 6	SHEET 75 OF 82