INDEX OF SHEETS
SEE SHEET 2

STATE OF VERMONT
AGENCY OF TRANSPORTATION

PROPOSED IMPROVEMENT
BRIDGE PROJECT
TOWN OF BENNINGTON
COUNTY OF BENNINGTON
VT. ROUTE 9
BRIDGE NO. 9

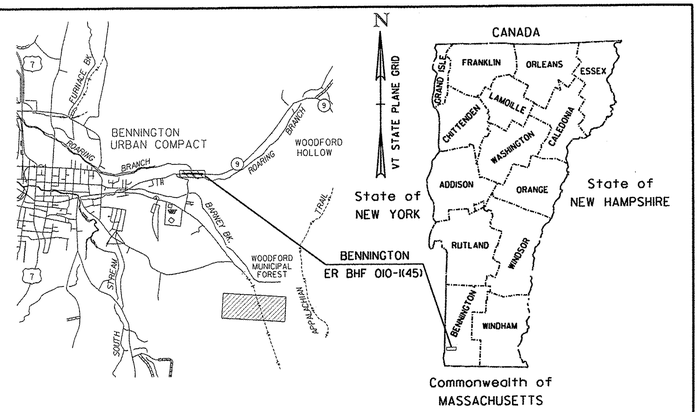

RECORD PLANS	
CONTRACTOR:	NORTHERN CONSTRUCTION, LLC.– WEYMOUTH,MA
RESIDENT ENGINEER:	RON LEMAIRE
CONSTRUCTION BEGAN:	MAY 7, 2013
CONSTRUCTION COMPLETE:	JANUARY 18, 2014
RECORD PLANS BY:	RON LEMAIRE ~~& STEVE KENT~~ RJM

I HEREBY CERTIFY THAT ALL THE CONSTRUCTION REQUIRED BY THIS SET OF DRAWINGS HAS BEEN ACCOMPLISHED AS INDICATED HEREIN.

BY _____ RESIDENT ENGINEER

DATE 10/23/14 See attached sheet for additional changes.

NOTE: Any further information concerning final quantities, amounts or other details relative to this project may be found at Central Files in the electronic archives.

PROJECT LOCATION: LOCATED IN THE COUNTY OF BENNINGTON, TOWN OF BENNINGTON, VT. ROUTE 9 OVER ROARING BRANCH OF THE WALLOOMSAC RIVER, APPROXIMATELY 2.0 MILES EAST OF THE U.S. ROUTE 7 AND VT. ROUTE 9 INTERSECTION.

PROJECT DESCRIPTON: CONSTRUCTION OF THE RETROFIT MICROPILE FOUNDATIONS FOR BOTH PIERS OF EXISTING THREE SPAN CONTINUOUS STEEL ROLLED BEAM BRIDGE NO. 9 OVER THE ROARING BRANCH OF THE WALLOOMSAC RIVER.

LENGTH OF ROADWAY 0.00 FT (0.000 MILES)
LENGTH OF PROJECT 0.00 FT (0.000 MILES)

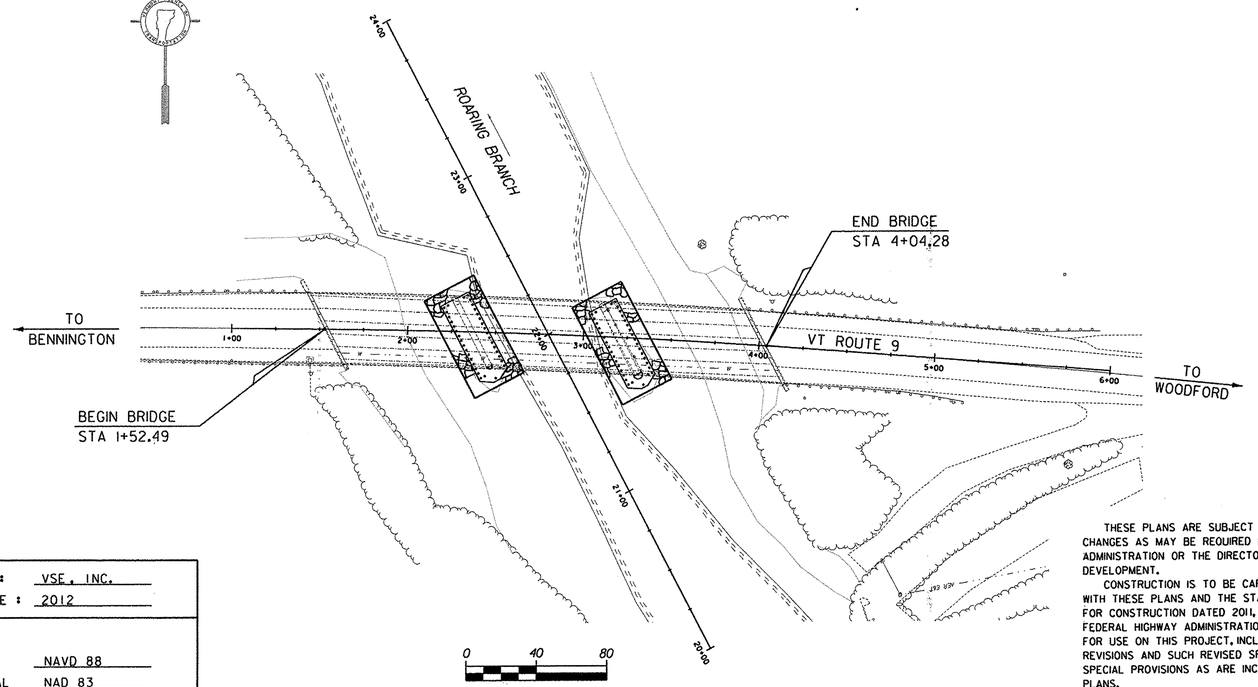

QUALITY ASSURANCE PROGRAM: LEVEL I

CONVENTIONAL SYMBOLS

COUNTY LINE
TOWN LINE
LIMITS OF ACCESS
POINT OF ACCESS
FENCE LINE
STONE WALL
TRAVELED WAY
GUARD RAIL
RAILROAD
SURVEY LINE
CULVERT
POWER POLE
TELEPHONE POLE
TREES
CONTROL OF ACCESS
PROPERTY LINE
R.O.W. TAKING LINE
SLOPE RIGHTS SR SR SR
TOP OF CUT
TOE OF SLOPE

SURVEYED BY : VSE, INC.
SURVEYED DATE : 2012

DATUM
VERTICAL NAVD 88
HORIZONTAL NAD 83

THESE PLANS ARE SUBJECT TO SUCH ENGINEERING CHANGES AS MAY BE REQUIRED BY THE FEDERAL HIGHWAY ADMINISTRATION OR THE DIRECTOR OF PROGRAM DEVELOPMENT.

CONSTRUCTION IS TO BE CARRIED ON IN ACCORDANCE WITH THESE PLANS AND THE STANDARD SPECIFICATIONS FOR CONSTRUCTION DATED 2011, AS APPROVED BY THE FEDERAL HIGHWAY ADMINISTRATION ON JULY 20, 2011 FOR USE ON THIS PROJECT, INCLUDING ALL SUBSEQUENT REVISIONS AND SUCH REVISED SPECIFICATIONS AND SPECIAL PROVISIONS AS ARE INCORPORATED IN THESE PLANS.

STATE OF VERMONT
ANTHONY MARK PAPALE
No. 8004
REGISTERED PROFESSIONAL ENGINEER

PLANS PREPARED BY

8/21/12

CHA
111 Winners Circle, PO Box 5269 • Albany, NY 12205-0269
Main: (518) 453-4500 • www.chacompanies.com

DIRECTOR OF PROGRAM DEVELOPMENT
APPROVED Kevin S. Marshia DATE 8/31/12

PROJECT MANAGER : JENNIFER FITCH

PROJECT NAME : BENNINGTON
PROJECT NUMBER : ER BHF 010-1(45)

SHEET 1 OF 40 SHEETS

FILE NAME = V:\Projects\ANY\K2\23770\CADD_MSTN\s11b326.cov.dgn
DATE/TIME = 8/21/2012
USER = 4065