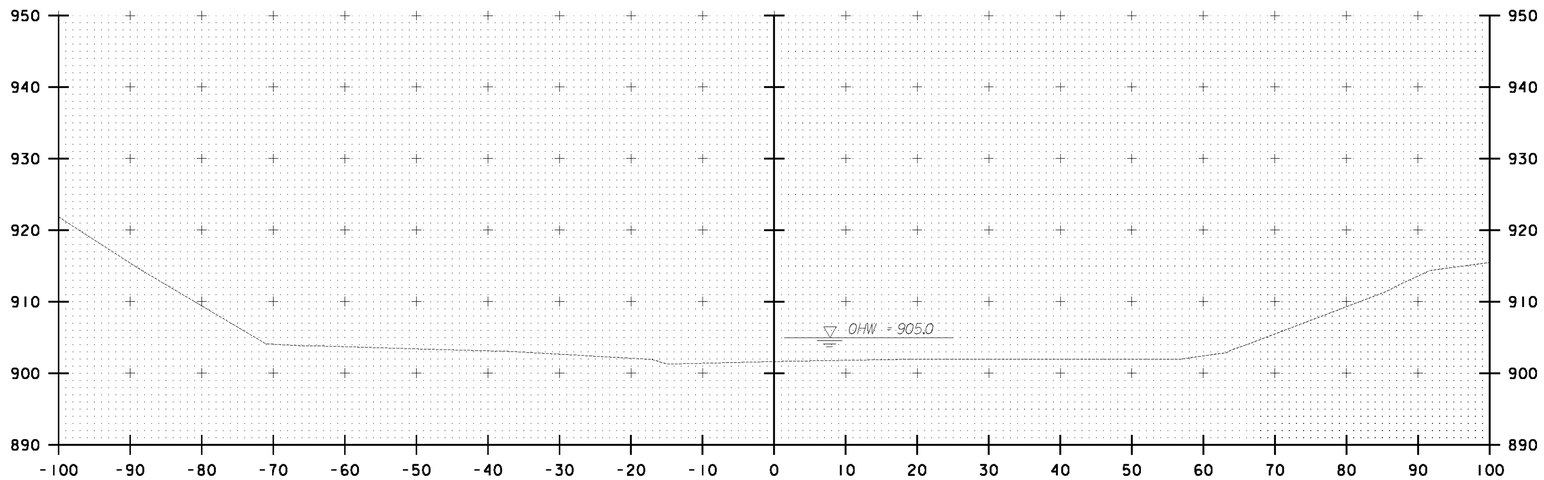

22+75.00

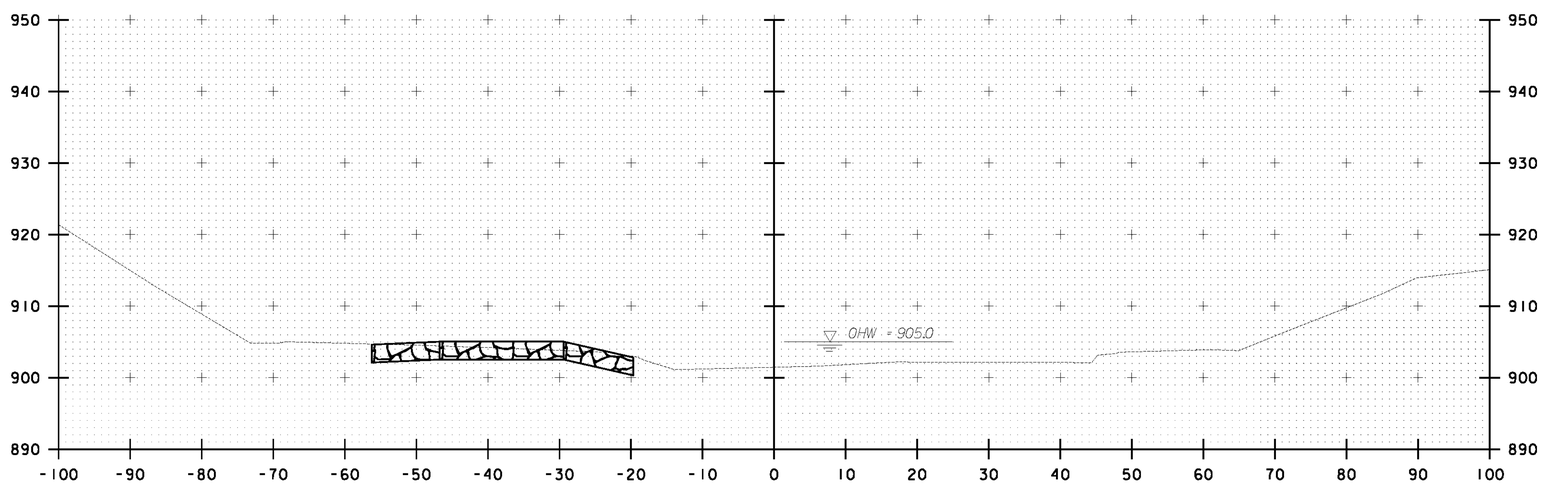

STA 22+50.00 LT
END RIPRAP, HEAVY TYPE
END STRUCTURE EXCAVATION
END GEOTEXTILE UNDER STONE FILL

22+50.00

0 10 20
SCALE IN FEET

CHA

CHANNEL CROSS SECTIONS SHEET #4

PROJECT NAME: BENNINGTON
PROJECT NUMBER: ER BHF 010-1(45)

FILE NAME: zllb326_xs_channel.dgn
PROJECT LEADER: D.E.G.
DESIGNED BY: B.T.H.
DWG. NO.: zllb326xs.1

PLOT DATE: 8/21/2012
DRAWN BY: W.E.P.
CHECKED BY: D.E.G.
SHEET 35 OF 40

FILE NAME = V:\Projects\ANY\K2\23770\CADD_MSTN\zllb326_xs_channel.dgn
DATE/TIME = 8/21/2012
USER = 4059