STATE OF VERMONT
AGENCY OF TRANSPORTATION

TRAFFIC SIGN SUMMARY SHEET 11

MILE MARKER, STATION OR SIGN NUMBER		SIGN DIMENSIONS EACH	WIDTH (in)	HEIGHT (in)	NEW & SALVAGED SIGNS "A"	"B"	SALV SIGN	SALV TIS	EXIST POST RETAIN	SALVAGE	NEW SIGN POSTS NO. OF POST	FLANGED CHANNEL (LB / FT) 1.12	2.00	3.00	SQUARE STEEL (in) (LB / FT) 1.75 1.88	2.00 2.42	2.50 3.35	ANCHOR	SLEEVE	TUBULAR ALUMINUM Ø (IN) (LB / FT) 3.00 1.30	4.00 1.70	4.0 MOD 1.70	FOUND-ATION	TUBULAR STEEL Ø (IN) (LB / FT) 3.00 7.60	3.50 9.00	4.00 10.80	5.00 14.60	W-SHAPE STEEL FTG. SIZE 24"	30"	WEIGHT	POST SIZE	SIGN FRAME REQUIRED	REMARKS SHSM = FHWA STANDARD HIGHWAY SIGNS AND MARKINGS BOOK	SIGN DETAIL DETAIL IN SHSM	DETAIL ON SHEET NUMBER	STANDARD SHEET NUMBER
OPTION ITEMS																																				
MM BT 1.737 LT BARRE TOWN	5-3-17 *EXISTING SPEED LIMIT 30	1	30	30			1				1					15		17 X															W14-2 SALVAGE SIGN ON NEW POST			
		1	12	18			1 1	* EXISTING SL 30 SALVAGED TO NEW POST																									SALVAGE SIGN ON NEW POST			
MM BT 1.738 LT BARRE TOWN		1	24	30	5.00				1																								VR-017			T-70
MM BT 1.795 RT BARRE TOWN		1	36	36	9.00						2					30		15.5 X 16.75															W11-6H-HINGED INSTALL SIGN IN CLOSED POSITION PROVIDE STAINLESS BOLTS / HARDWARE TO INSTALL IN OPEN POSITION	SHSM		
MM BT 1.800 RT BARRE TOWN		1	6	10	0.42						1				8			9 X															VD-700			T-44
MM BT 1.871 LT BARRE TOWN	5-21-17	1	36	36	9.00						2					30		15.75 X 14.5															W2-2R FLUORESCENT YELLOW SHEETING	SHSM		
	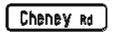	1	30	8	1.67																												W16-8P FLUORESCENT YELLOW SHEETING		63	
MM BT 1.985 LT BARRE TOWN	5-3-17	1	36	36	9.00						2					30		15 X 14															W11-6H-HINGED INSTALL SIGN IN CLOSED POSITION PROVIDE STAINLESS BOLTS / HARDWARE TO INSTALL IN OPEN POSITION	SHSM		
MM BT 2.000 LT BARRE TOWN		1	6	10	0.42						1				8			8.5 X															VD-700			T-44
															FT ~~16~~ 17.5	FT ~~105~~ 108.5	FT 0		EA					LB	LB	LB	LB								
TOTALS					SF 34.51	SF	EA. ~~2~~ 3	SF				FT			FT					LB			EA.	LB				EA.	EA.	LB					

FINAL POST LENGTHS ARE TO BE DETERMINED IN THE FIELD. POST SIZES ARE COMPUTED BASED ON INFORMATION FURNISHED ON THE STANDARD SHEETS AND THE VTRANS "SIGN POST DESIGN GUIDELINE."

PROJECT NAME: BERLIN-BARRE TOWN
PROJECT NUMBER: STP 2943(I)

FILE NAME: z11b338tsss.dgn
PROJECT LEADER: C. LATHROP
DESIGNED BY: S. SOLLA
TRAFFIC SIGN SUMMARY SHEET II

PLOT DATE: 4/26/2016
DRAWN BY: O. DALMER
CHECKED BY: C. LATHROP
SHEET 56 OF 202