SITE	LOCATION STA.	LOCATION STA.	POS.	FEET OF DITCHING PERCENT GRADE 0-2.5	FEET OF DITCHING PERCENT GRADE 2.5-10	MISC. ITEMS 653.20 TEMP. EROS. MATT. SY	MISC. ITEMS 613.10 STONE FILL TYP. I CY	REMARKS
	VT 64							
	NORTHFIELD							
	M.M.	M.M.						
1	0.0	0.2	RT					
2	0.20	0.40	LT		1056		156	
3	0.40	1.00	LT	3168		1408		
	WILLIAMSTOWN							
4	W 0.20	W 0.30	LT		528		78	
5	W 0.20	W 0.30	RT		528		78	
6	W 0.22	W 0.37	LT		792		25	25 CY STONE FILL, TYPE I ADDED AT REQUEST OF THE RESIDENT ENGINEER
7	W 0.50	W 0.65	LT		792		117	
8	W 1.70	W 1.85	LT		792		117	
9	W 1.70	W 1.85	RT		792		117	
10	W 2.00	W 2.10	LT		528		78	
11	W 2.30	W 2.40	LT		528		78	
12	W 2.50	W 2.60	LT		528		78	
13	W 2.60	W 2.90	LT		1584		235	
14	W 3.10	W 3.30	RT		1056		156	
15	W 3.30	W 3.40	LT		264		39	
	SUBTOTAL					1408	1352	
	ROUNDING					-	-	
	TOTAL					1408	1352	

SITE	LOCATION STA.	LOCATION STA.	POS.	FEET OF DITCHING PERCENT GRADE 0-2.5	FEET OF DITCHING PERCENT GRADE 2.5-10	MISC. ITEMS 653.20 TEMP. EROS. MATT. SY	MISC. ITEMS 613.10 STONE FILL TYP. I CY	REMARKS

SITE	LOCATION STA.	LOCATION STA.	POS.	FEET OF DITCHING PERCENT GRADE 0-2.5	FEET OF DITCHING PERCENT GRADE 2.5-10	MISC. ITEMS 653.20 TEMP. EROS. MATT. SY	MISC. ITEMS 613.10 STONE FILL TYP. I CY	REMARKS

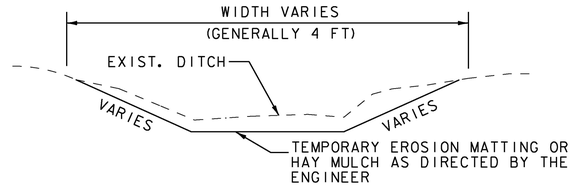

DITCH DETAIL 0 TO <2.5 PERCENT

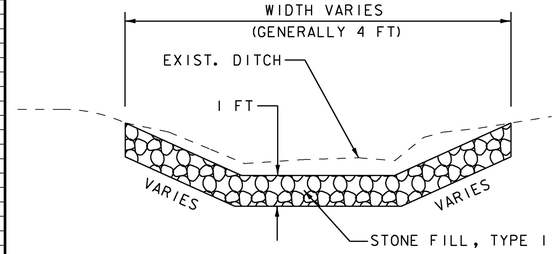

DITCH DETAIL
2.5 PERCENT TO 10 PERCENT

NOTES:

1. GRADES BETWEEN 0 AND 2.5 PERCENT SHALL USE ITEM 651.25 HAY MULCH OR ITEM 653.20 TEMPORARY EROSION MATTING AS DIRECTED BY THE ENGINEER.

2. GRADES BETWEEN 2.5 PERCENT TO 10 PERCENT SHALL USE ITEM 613.10 STONE FILL, TYPE I AS DIRECTED BY THE ENGINEER.

3. ANY GRADE GREATER THAN 10 PERCENT SHALL USE ITEM 613.11 STONE FILL, TYPE II AS DIRECTED BY THE ENGINEER.

4. PIPE INLET AND OUTLET AREAS, AND DITCH CLEANING THROUGHOUT THE PROJECT, SHALL BE PERFORMED AT LOCATIONS IDENTIFIED ON THIS SHEET AND AS DIRECTED BY THE ENGINEER. PAYMENT WILL BE UNDER THE APPLICABLE RENTAL ITEM(S).

NOT TO SCALE

PROJECT NAME: NORTHFIELD-WILLIAMSTOWN
PROJECT NUMBER: STP 2959(I)

FILE NAME: z15v022det.dgn
PROJECT LEADER: C. LATHROP
DESIGNED BY: J. GOODALL
DITCH CLEANING DETAIL SHEET

PLOT DATE: 4/26/2016
DRAWN BY: J. GOODALL
CHECKED BY: C. LATHROP
SHEET 90 OF 202