STATE OF VERMONT
AGENCY OF TRANSPORTATION

TRAFFIC SIGN SUMMARY SHEET 1

MILE MARKER, STATION OR SIGN NUMBER		SIGN DIMENSIONS			NEW & SALVAGED SIGNS				EXIST POST		NEW SIGN POSTS																						REMARKS	SIGN DETAIL		
											NO. OF	FLANGED CHANNEL			SQUARE STEEL (in)					TUBULAR ALUMINUM Ø (IN)			FOUND-ATION	TUBULAR STEEL Ø (IN)				W-SHAPE STEEL									
															1.75	2.00	2.50			3.00	4.00	4.0 MOD		3.00	3.50	4.00	5.00	FTG. SIZE								
		EACH	WIDTH (in)	HEIGHT (in)	"A"	"B"	SALV SIGN	SALV TIS	RETAIN	SALVAGE	POST	(LB / FT)			(LB / FT)			ANCHOR	SLEEVE	(LB / FT)				(LB / FT)				24"	30"	WEIGHT	POST SIZE	SIGN FRAME REQUIRED	SHSM = FHWA STANDARD HIGHWAY SIGNS AND MARKINGS BOOK	DETAIL IN SHSM	DETAIL ON SHEET NUMBER	STANDARD SHEET NUMBER
												1.12	2.00	3.00	1.88	2.42	3.35			1.30	1.70	1.70		7.60	9.00	10.80	14.60									
OPTION ITEMS																																				
MM 0.011 RT NORTHFIELD	4-26-17	1	36	36	9.00						2					30		13.5 X 14.5														R1-1	SHSM		
MM 0.013 LT NORTHFIELD	9-7-17	1	36	36	9.00						2					30		12.5 X 12.5														R1-1	SHSM		
	9-7-17		6	10	0.42																											VD-700 --- MOUNT MILE MARKER BACK TO BACK WITH STOP SIGN			T-44
MM 0.026 LT NORTHFIELD	5-26-17	1 1	24 24	12 12	2.00 2.00						2					30		16.25 X 16.25													#2	M3-3 --- GREEN ON WHITE M3-1 --- GREEN ON WHITE	SHSM SHSM		
		1 1	24 24	24 24	4.00 4.00																											M1-5 M1-5			E-136B E-136B
	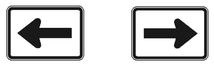	1 1	21 21	15 15	2.19 2.19																											M6-1L --- GREEN ON WHITE M6-1R --- GREEN ON WHITE	SHSM SHSM		
FINAL POST LENGTHS ARE TO BE DETERMINED IN THE FIELD. POST SIZES ARE COMPUTED BASED ON INFORMATION FURNISHED ON THE STANDARD SHEETS AND THE VTRANS "SIGN POST DESIGN GUIDELINE."												FT			FT	FT 90	FT		EA				EA	LB	LB	LB	LB								
	TOTALS				SF 34.8	SF	EA.	SF				FT			FT 90					LB			EA.	LB				EA.	EA.	LB					

PROJECT NAME: NORTHFIELD-WILLIAMSTOWN
PROJECT NUMBER: STP 2959(I)

FILE NAME: zl5v022tsss.dgn
PROJECT LEADER: C. LATHROP
DESIGNED BY: J. GOODALL
TRAFFIC SIGN SUMMARY SHEET 1

PLOT DATE: 4/26/2016
DRAWN BY: O. DALMER
CHECKED BY: C. LATHROP
SHEET 105 OF 202