STATE OF VERMONT
AGENCY OF TRANSPORTATION

TRAFFIC SIGN SUMMARY SHEET 14

MILE MARKER, STATION OR SIGN NUMBER		SIGN DIMENSIONS			NEW & SALVAGED SIGNS				EXIST POST		NEW SIGN POSTS																						REMARKS	SIGN DETAIL		
		EACH	WIDTH (in)	HEIGHT (in)	"A"	"B"	SALV SIGN	SALV TIS	RETAIN	SALVAGE	NO. OF POST	FLANGED CHANNEL (LB / FT)			SQUARE STEEL (in) (LB / FT)			ANCHOR	SLEEVE	TUBULAR ALUMINUM Ø (IN) (LB / FT)			FOUND-ATION	TUBULAR STEEL Ø (IN) (LB / FT)				W-SHAPE STEEL					SHSM = FHWA STANDARD HIGHWAY SIGNS AND MARKINGS BOOK	DETAIL IN SHSM	DETAIL ON SHEET NUMBER	STANDARD SHEET NUMBER
															1.75	2.00	2.50			3.00	4.00	4.0 MOD		3.00	3.50	4.00	5.00	FTG. SIZE		WEIGHT	POST SIZE	SIGN FRAME REQUIRED				
												1.12	2.00	3.00	1.88	2.42	3.35			1.30	1.70	1.70		7.60	9.00	10.80	14.60	24"	30"						
OPTION ITEMS																																			
MM W 0.273 RT WILLIAMSTOWN	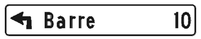 5-9-17	1	72	12	6.00				2																								VD1-1A --- REPLACE SIGN ON RETAINED TUBULAR STEEL POSTS			T-93
		1	72	12	6.00																												VD1-1A --- REPLACE SIGN ON RETAINED TUBULAR STEEL POSTS			T-93
		1	24	12																													M3-1 --- WHITE ON BLUE. RETAIN SIGN ON TUBULAR STEEL POST	SHSM		
		1	24	24																													M1-1 --- RETAIN SIGN ON TUBULAR STEEL POST	SHSM		
		1	21	15																													M5-1L --- WHITE ON BLUE. RETAIN SIGN ON TUBULAR STEEL POST	SHSM		
MM W 0.318 LT WILLIAMSTOWN	5-9-17	1	72	12	6.00				2																								VD1-1A --- REPLACE SIGN ON RETAINED TUBULAR STEEL POSTS			T-93
		1	72	12	6.00																												VD1-1A --- REPLACE SIGN ON RETAINED TUBULAR STEEL POSTS			T-93
		1	24	12																													M3-3 --- WHITE ON BLUE. RETAIN SIGN ON TUBULAR STEEL POST	SHSM		
		1	24	24																													M1-1L --- RETAIN SIGN ON TUBULAR STEEL POST	SHSM		
		1	21	15																													M5-1 --- WHITE ON BLUE. RETAIN SIGN ON TUBULAR STEEL POST	SHSM		
												FT			FT	FT	FT		EA					LB	LB	LB	LB								
	TOTALS				SF 24.00	SF	EA.	SF				FT			FT					LB			EA.		LB				EA.	EA.	LB					

FINAL POST LENGTHS ARE TO BE DETERMINED IN THE FIELD. POST SIZES ARE COMPUTED BASED ON INFORMATION FURNISHED ON THE STANDARD SHEETS AND THE VTRANS "SIGN POST DESIGN GUIDELINE."

PROJECT NAME: NORTHFIELD-WILLIAMSTOWN
PROJECT NUMBER: STP 2959(I)

FILE NAME: zl5v022tsss.dgn
PROJECT LEADER: C. LATHROP
DESIGNED BY: J. GOODALL
TRAFFIC SIGN SUMMARY SHEET 14

PLOT DATE: 4/26/2016
DRAWN BY: O. DALMER
CHECKED BY: C. LATHROP
SHEET 118 OF 202