STATE OF VERMONT
AGENCY OF TRANSPORTATION

TRAFFIC SIGN SUMMARY SHEET 2

MILEMARKER, STATION, OR SIGN NUMBER	SIGN LEGEND	SIGN DIMENSIONS EA	WIDTH (In)	HEIGHT (In)	NEW & SALVAGED SIGNS "A"	"B"	SALV SIGN	SALV TIS	EXIST POST RETAIN	EXIST POST SALVAGE	NEW SIGN POSTS NO. OF POSTS	FLANGED CHANNEL lb/ft 1.12	2.0	3.0	SQUARE STEEL (In) 2.0 lb/ft 2.16	2.0 lb/ft 2.42	2.5 lb/ft 3.35	ANCHOR	SLEEVE	TUBULAR ALUMINUM Ø (In) 3.0 lb/ft 1.3	4.0 lb/ft 1.7	4.0 MOD lb/ft 1.7	FOUNDATION	TUBULAR STEEL Ø (In) 3.0 lb/ft 7.6	3.5 lb/ft 9.0	4.0 lb/ft 10.8	5.0 lb/ft 14.6	W-SHAPE STEEL FTG. SIZE 24"	30"	WEIGHT	POST SIZE	SIGN FRAME REQUIRED	REMARKS	SIGN DETAIL SHSM	DETAIL ON SHEET NUMBER	STD. SHEET NUMBER
												OPTION ITEMS																											
STA. 69+25.00, RT		1	60	30	12.50						2					14 X 15		X																VR-941		E-145A
STA. 70+35.88, LT		1 1 1 1 1 1 1	66 24 24 30 24 21 21	12 12 12 24 24 15 15	5.50 2.00 2.00 5.00 4.00 2.19 2.19						2					16 X 17		X														X	GREEN ON WHITE GREEN ON WHITE GREEN ON WHITE	D1-1 M3-4 M4-5 M1-5 M1-1 M6-3 M6-3		E-136B E-136B E-136B
STA. 71+53.10, RT		1	36	36	9.00						1					14 X		X																R1-2		
STA. 71+78.12, RT		1 1	36 18	36 18	9.00 2.25						2					14 X 14		X																W12-1 OM-1		
STA. 72+14.66, LT		1 1 1 1	~~36~~ 24 24 18 18	~~36~~ 24 30 18 18	~~9.00~~ 4.00 5.00 2.25 2.25						2					12.5 X		X																R3-4 R4-7 OM-1 OM-1		
STA. 72+23.97, RT		1	30	30	6.25						1					14 X		X																VR-921L		E-145A
STA. 73+34.92, RT		1	36	36	9.00						2					14 X 15		X																VR-046		E-142
STA. 73+53.43, LT		1	18	18	2.25						1					9 X		X																OM-1		
STA. 73+63.16, LT	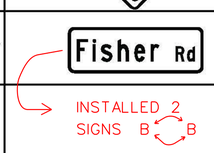	1	48	12	4.00						2					13 X 13		X																D3-1	70	
SHEET TOTALS					SF ~~99.63~~ 94.63	SF	EA	SF				FT	FT	FT	FT	FT 225	FT ~~255~~ 218.5		EA	LB	LB	LB	EA	LB	LB	LB	LB	EA	EA	LB						

SHS = 2004 FHWA STANDARD HIGHWAY SIGNS & MARKINGS/2012 SUPP.
FYG = FLUORESCENT YELLOW GREEN

FINAL POST LENGTHS ARE TO BE DETERMINED IN THE FIELD. POST SIZES ARE COMPUTED BASED ON INFORMATION FURNISHED ON THE STANDARD SHEETS AND THE VTRANS "SIGN POST DESIGN GUIDELINE."

PROJECT NAME: BERLIN
PROJECT NUMBER: STPG SGNL(40)

FILE NAME: t11b358frm.dgn
PROJECT LEADER: P. COBURN
DESIGNED BY: T. SISSON
TRAFFIC SIGN SUMMARY SHEET 2

PLOT DATE: 10/28/2014
DRAWN BY: T. SISSON
CHECKED BY: M. LACROIX
SHEET 64 OF 123