
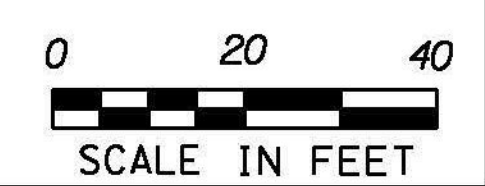


BUCKLAND SILT LOAM
8 TO 15 PERCENT SLOPES
HYDROGROUP = C
K FACTOR = 0.32

MATCH LINE STA 76+00

MATCH LINE STA 81+77.14

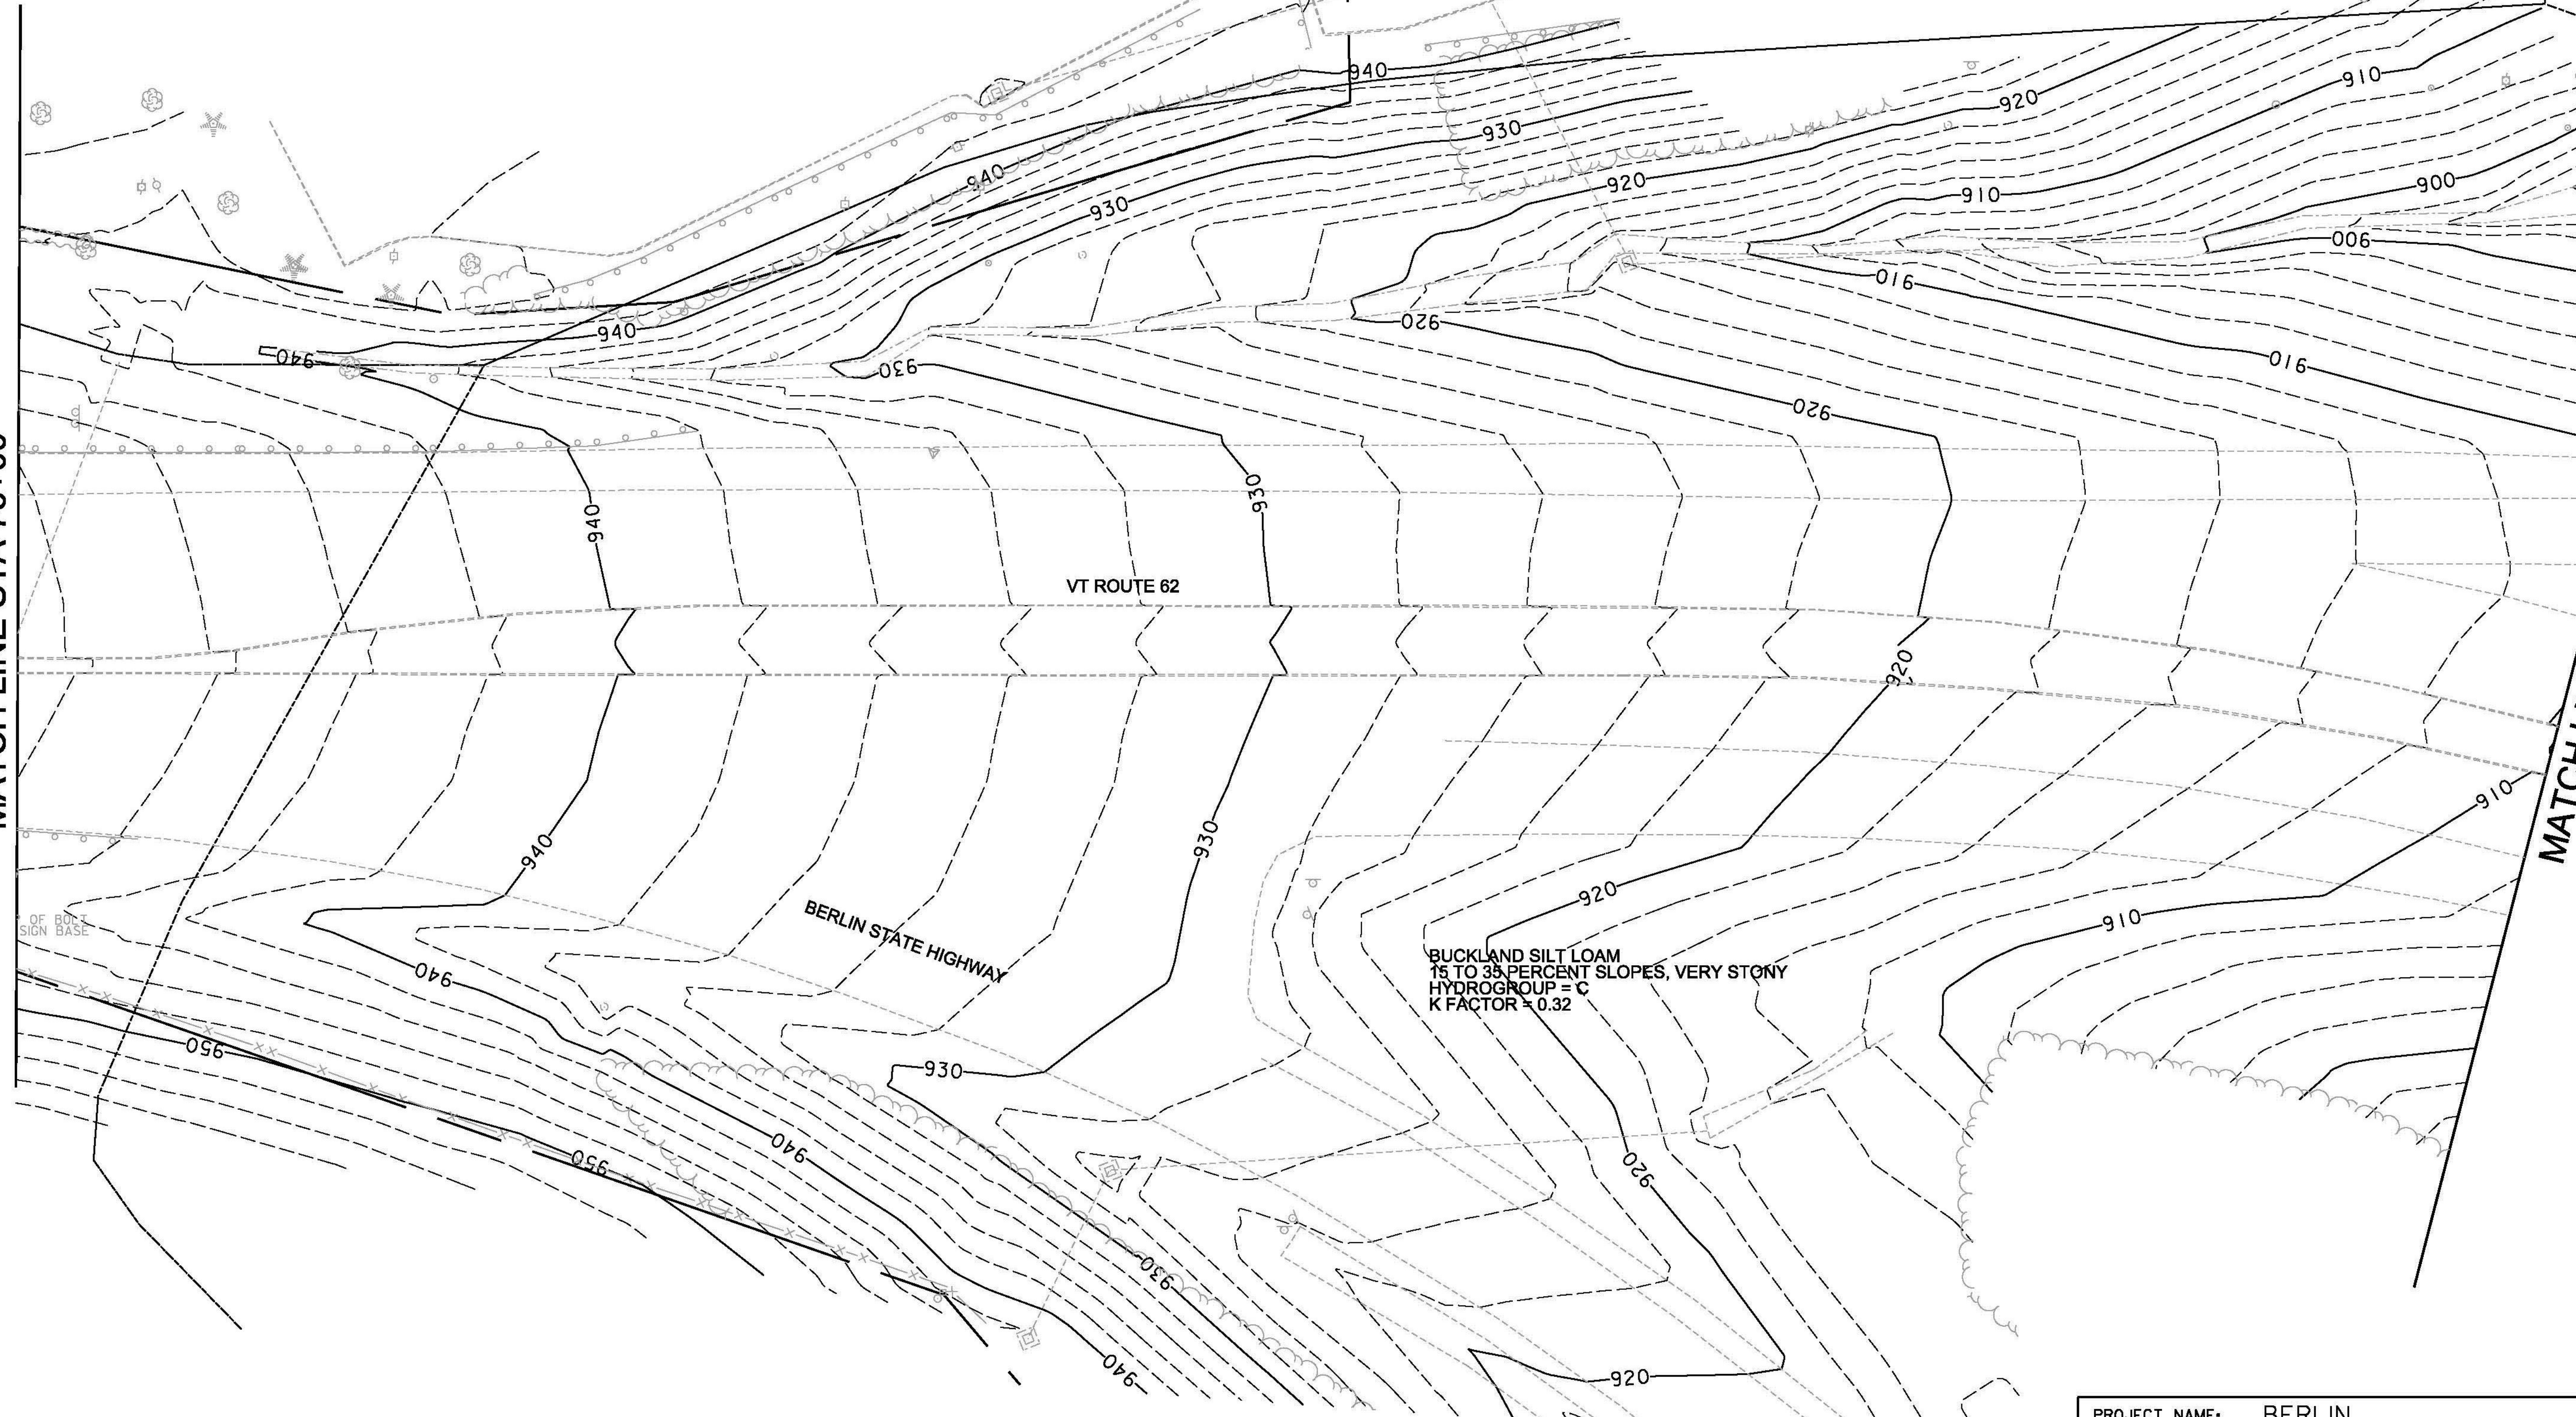

PROJECT NAME:	BERLIN	PLOT DATE:	10/20/2014
PROJECT NUMBER:	STPG SGNL(40)	DRAWN BY:	T. SISSON
FILE NAME:	+lib358bdr.dgn	CHECKED BY:	M. LACROIX
PROJECT LEADER:	P. COBURN	SHEET	80 OF 123
DESIGNED BY:	T. SISSON		
EPSC EXISTING CONDITIONS SHEET 5			