


BUCKLAND SILT LOAM
 15 TO 25 PERCENT SLOPES
 HYDROGROUP = C
 K FACTOR = 0.32


LIMITS OF CONSTRUCTION
STA. 109+68.33

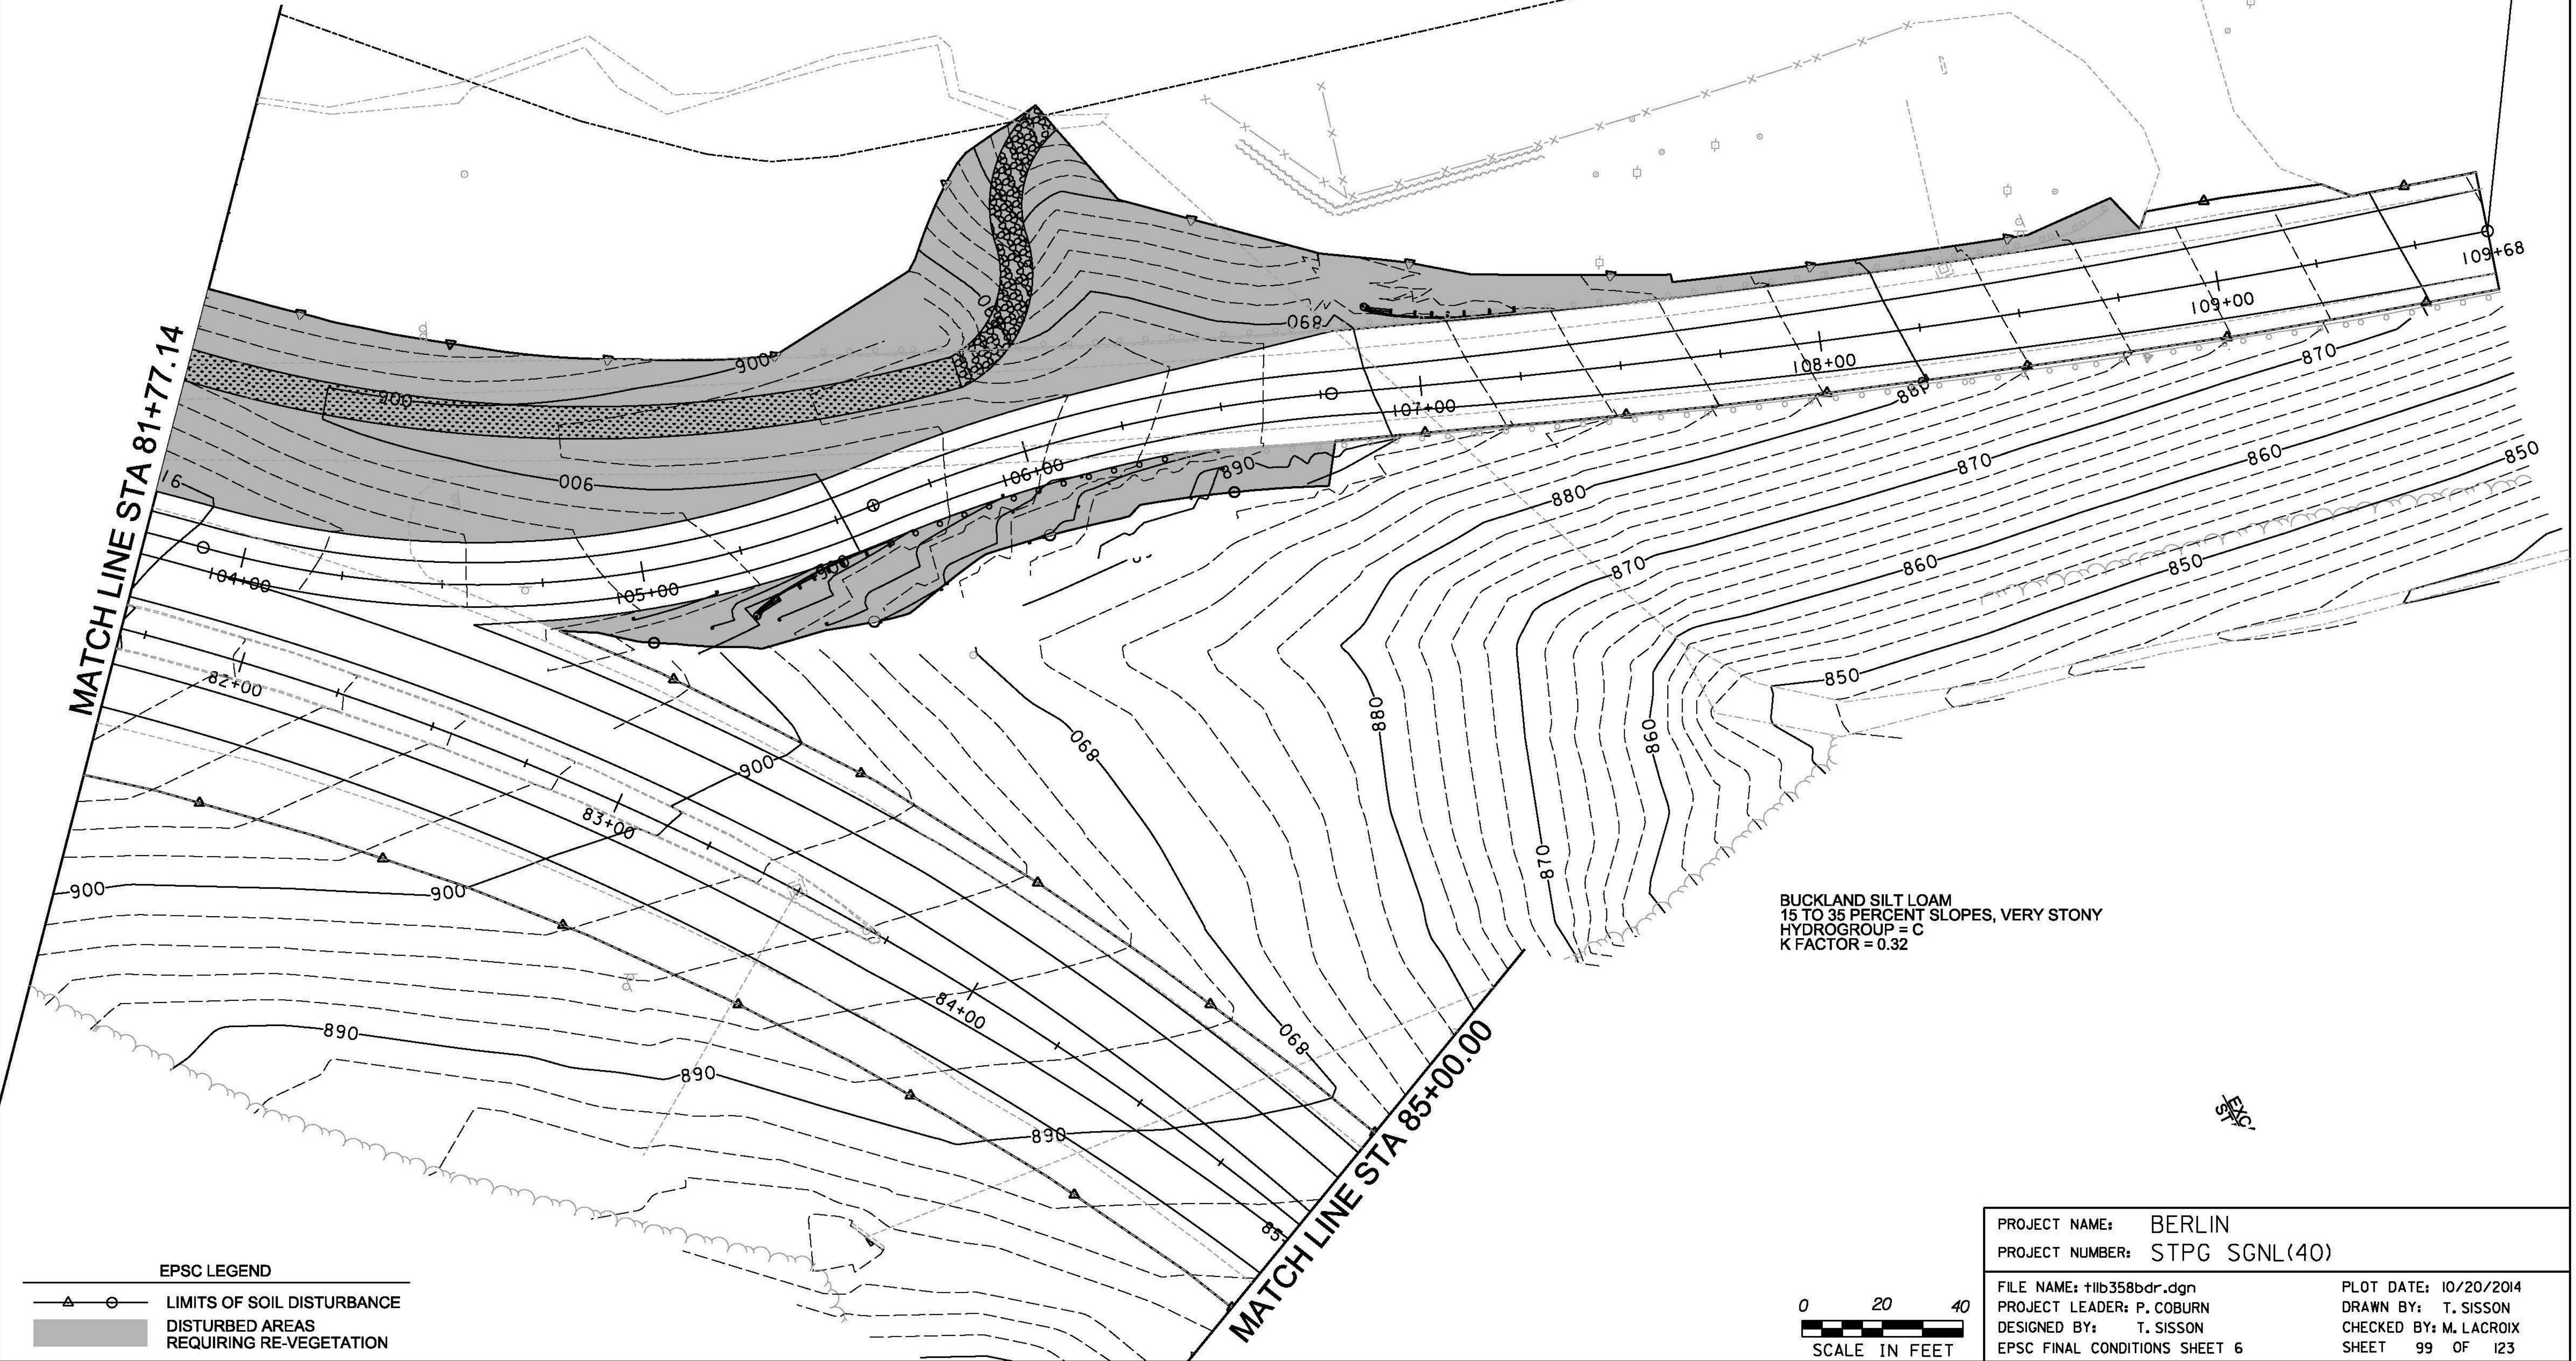

BUCKLAND SILT LOAM
 15 TO 35 PERCENT SLOPES, VERY STONY
 HYDROGROUP = C
 K FACTOR = 0.32

EPSC LEGEND

	LIMITS OF SOIL DISTURBANCE
	DISTURBED AREAS REQUIRING RE-VEGETATION

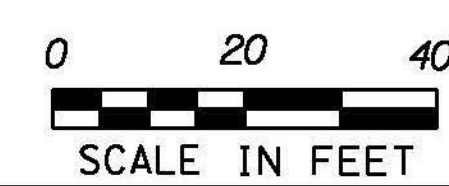

PROJECT NAME: BERLIN	PLOT DATE: 10/20/2014
PROJECT NUMBER: STPG SGNL(40)	DRAWN BY: T. SISSON
FILE NAME: +11b358bdr.dgn	CHECKED BY: M. LACROIX
PROJECT LEADER: P. COBURN	SHEET 99 OF 123
DESIGNED BY: T. SISSON	EPSC FINAL CONDITIONS SHEET 6