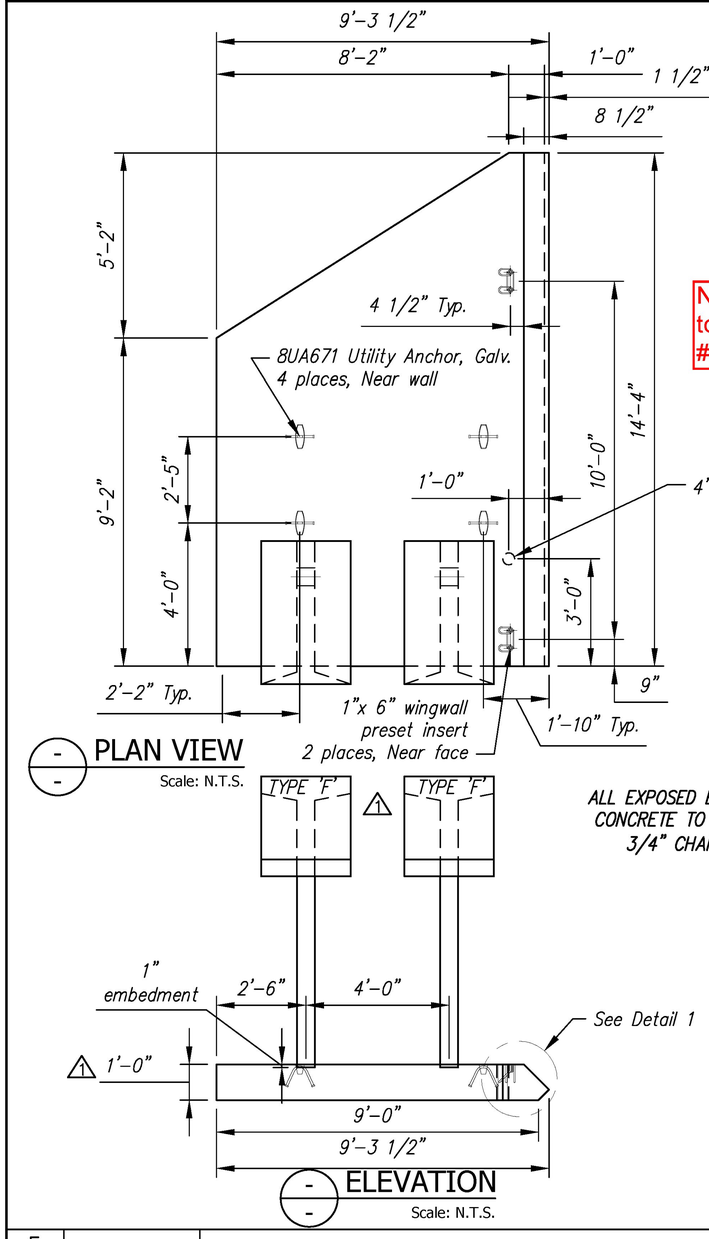

PLAN VIEW

Scale: N.T.S.

ELEVATION

Scale: N.T.S.

ALL EXPOSED EDGES OF CONCRETE TO RECEIVE 3/4" CHAMFER

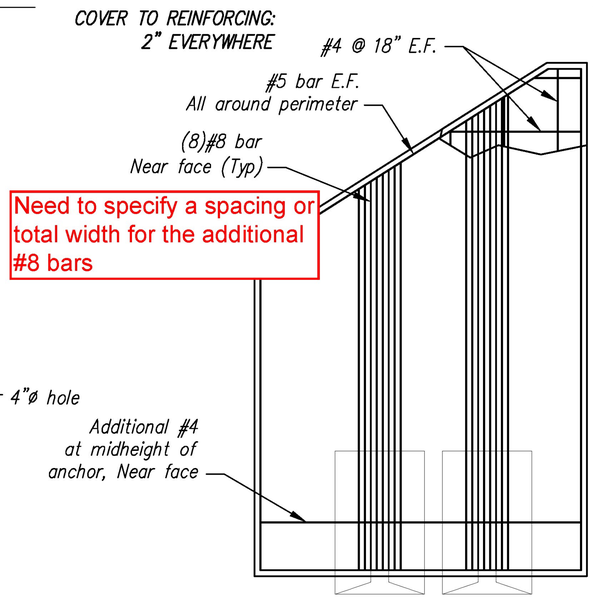

REINFORCING DETAIL

Scale: N.T.S.

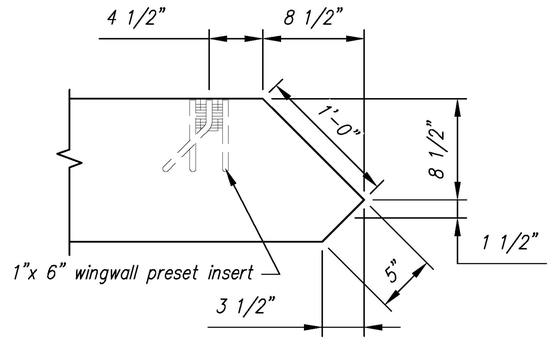

DETAIL 1

Scale: N.T.S.

WW2B - BILL OF MATERIALS / EMBEDS

CSI ID#	DESCRIPTION	QTY	UM	COMMENTS
1 CSANC-F	CON/SPAN WINGWALL ANCHOR (F)	2	EA	
CT-00005	CONSOLIDECK SALTGUARD (SILANE SILOXANE)	0.64	GA	
EM-0005A	1" X 6 " PRESET WING INSERTS	2	EA	
EM-00034	4" FOAM CORE PVC	1	FT	
EM-00115	UTILITY ANCHOR #8UA671-GALVANIZED	4	EA	
RM-00013	REBAR #4 BLACK- GR 60	226	LB	
RM-00015	REBAR #5 BLACK-GR 60 40'	88	LB	
RM-00104	REBAR #8 BLACK-GR 60	598	LB	
MX-FA5000SC30	MIX DESIGN - FLY ASH 5000 SELF CONSOLIDATING	4.01	CY	

REVIEWED		Stantec
REVIEWED AS MODIFIED	X	
REVISE AND RESUBMIT		
NOT REVIEWED		

Date: 5/1/2015

By: Nathan Tirk

This review by Stantec Consulting Services Inc. is for the sole purpose of ascertaining conformance with the general design concept. This review shall not mean that Stantec Consulting Services Inc approves the detail design inherent in the shop drawings, responsibility for which shall remain with the Contractor. Submitting same, and such review shall not relieve the Contractor of his responsibility for errors or omissions in the shop drawing or of his responsibility for meeting all requirements of the Contract Documents. The contractor is responsible for dimensions to be confirmed and correlated at the job site, for information that pertains solely to the fabrication processes or to techniques of construction and installation and for coordination of the work of all subtrades.

Vermont Agency of Transportation

RECEIVED

ON: April 30, 2015

and Checked for

CONFORMANCE

BY: Mark Sargent DATE: 5/7/2015

Rev.	Date	DESCRIPTION	By
5			
4			
3			
2			
1	01APR2015	ANCHORS WERE TYPE 'D', WALL WAS 10" THK	RY

REVISIONS

Concrete Systems Inc.
9 Commercial St., Hudson, NH,03051
Phone 603-889-4163
Fax 603-889-2417

STATE AGENCY

VTrans Working to Get You There VERMONT AGENCY OF TRANSPORTATION

Drawn By R. YEAGER	Date 16MAR2015
Concrete Cu. Yd. 5.39	Weight in Tons 10.91
Approved By	Date

J A MCDONALD, INC.

VT/AOT BRIDGE – STEEL CULVERT REPLACEMENT

BRIDGE #7, VT ROUTE 58, IRASBURG, VT

B

SHOP DRAWING – WW2B

Drawing No. C22283–L02–WW2B

REV 1

Quantity: 1 | Project No: STPCULV30 | SHEET 6 OF 9